


DIMENSIONS IN MILLIMETRES
(INCHES IN BRACKETS)

IF IN DOUBT ASK
THIRD ANGLE PROJECTION




TO SUPPLY DISTRIBUTION PLATE. 24V. D.C.
SEE DRG. C/ETS 2715 sht. 1

46
+ ⊕
47
- ⊖

TEST

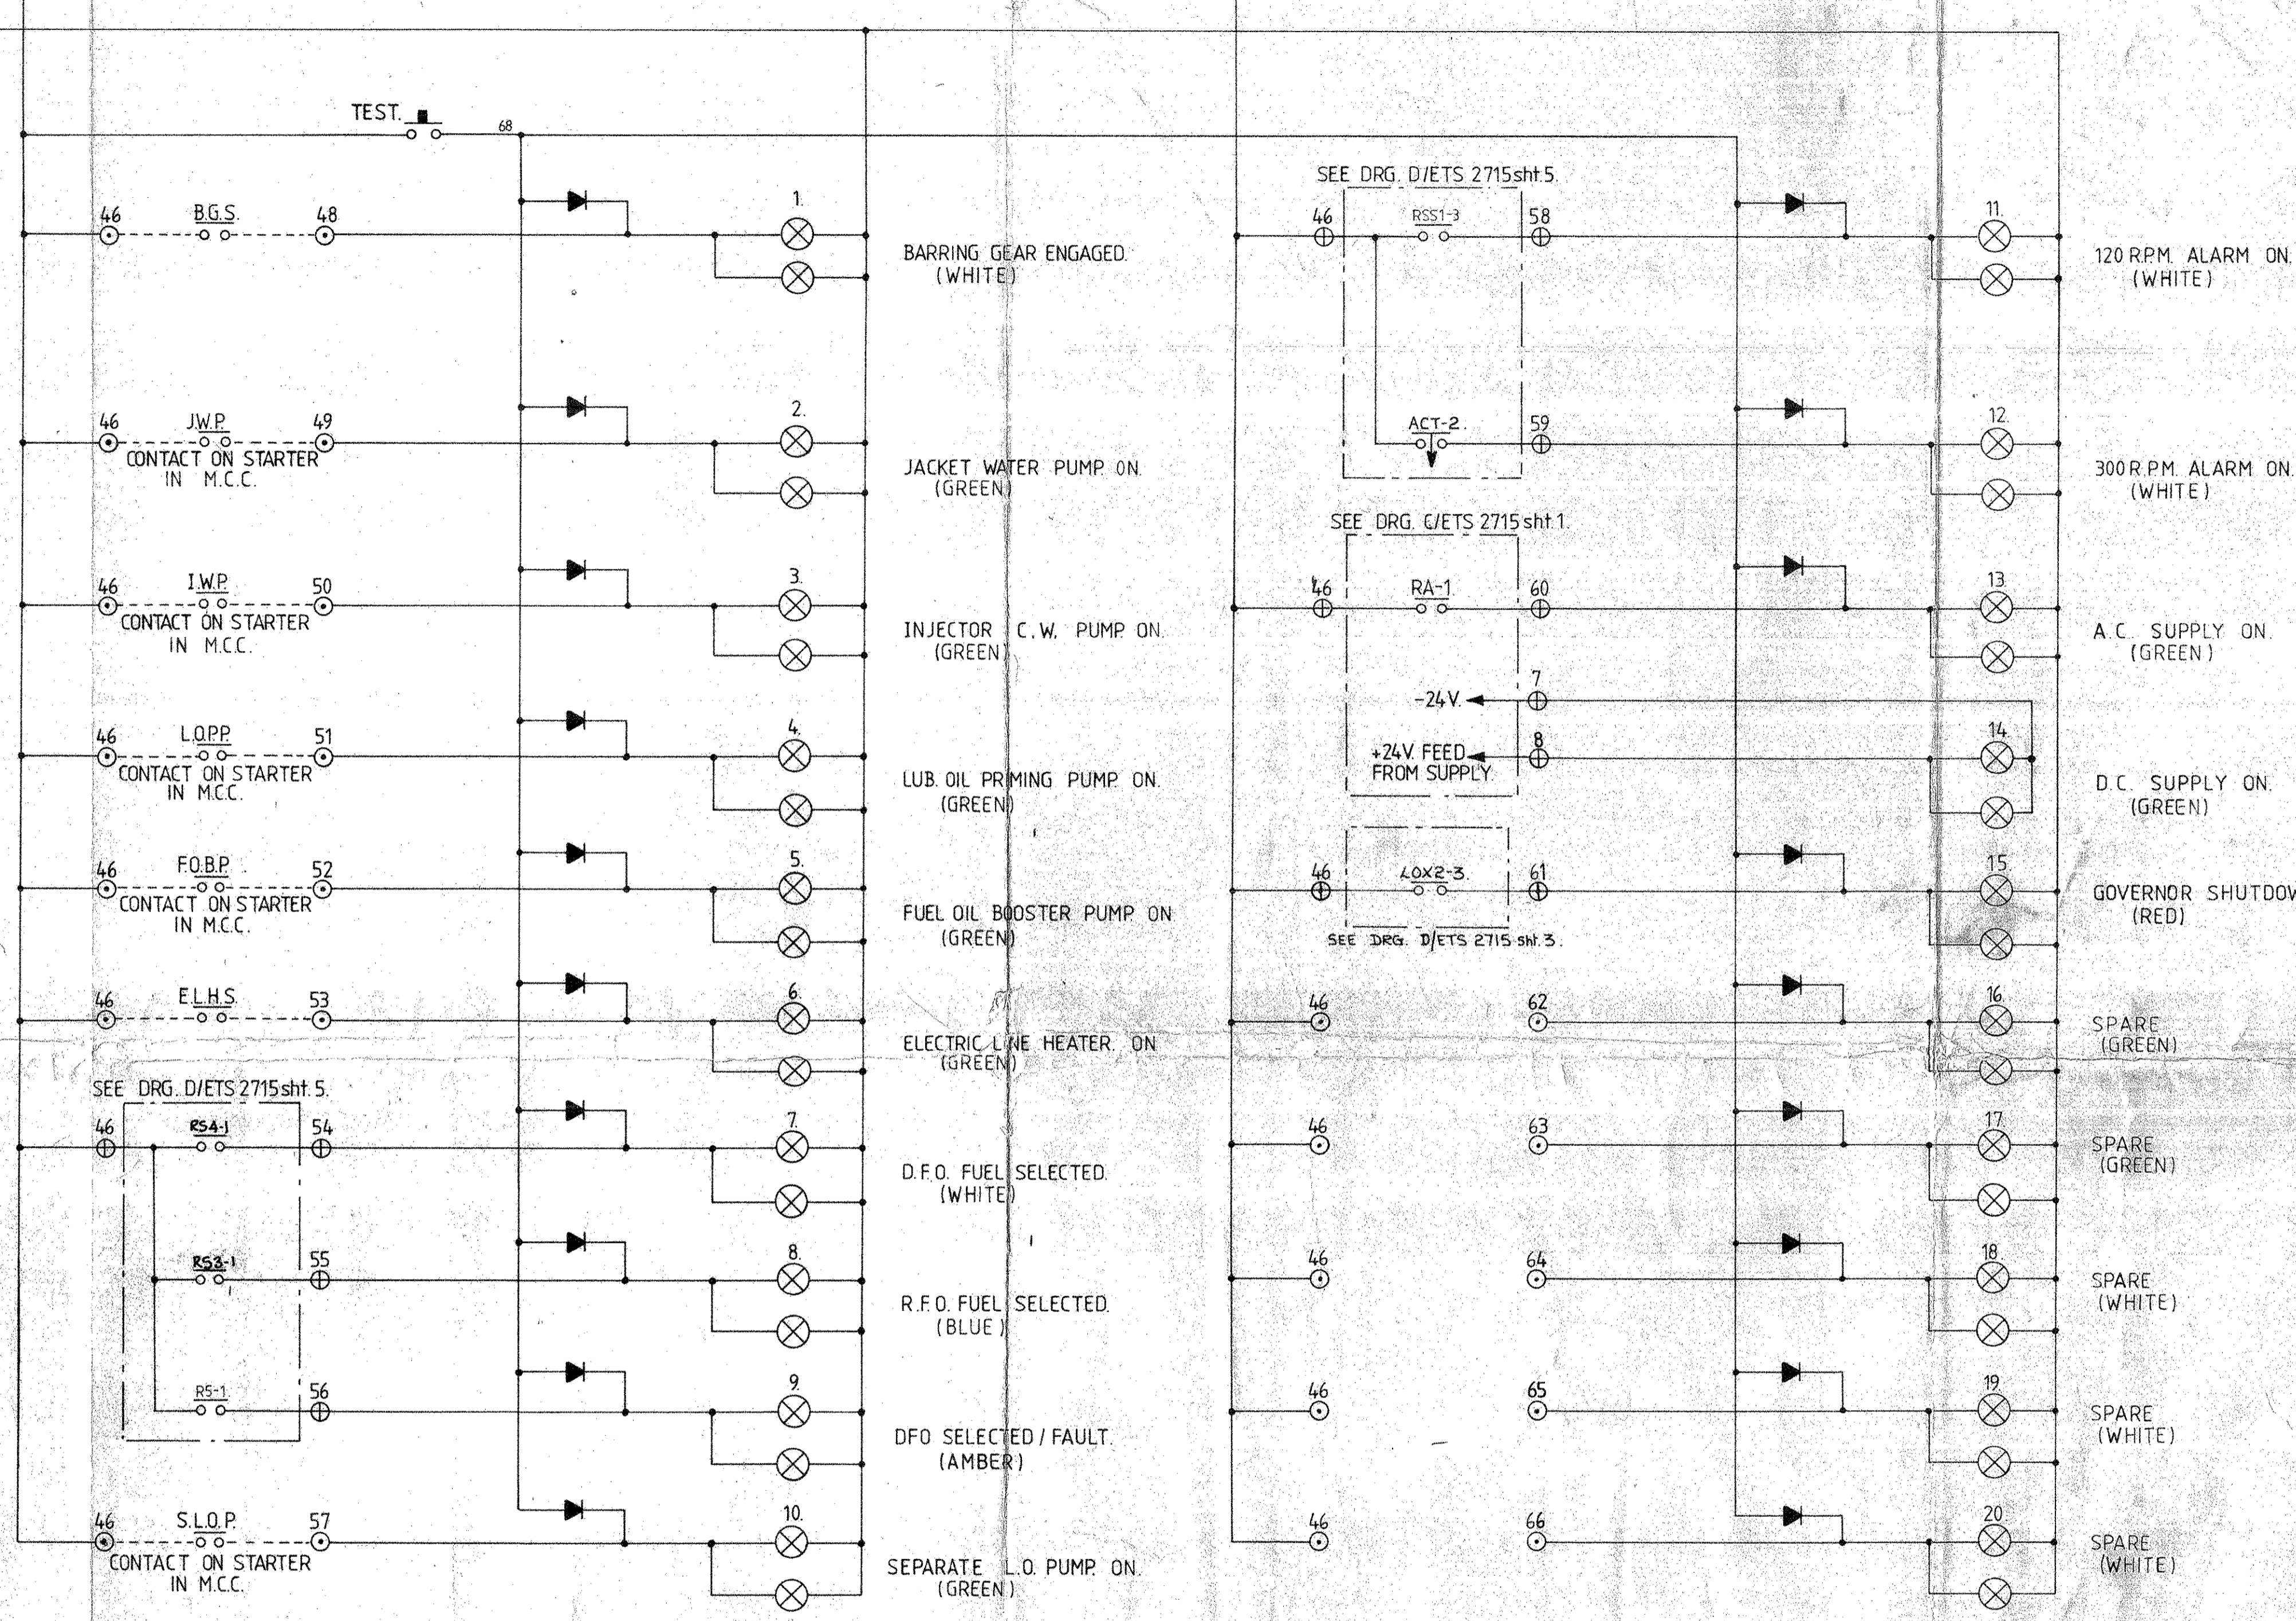

TERMINAL LAYOUT

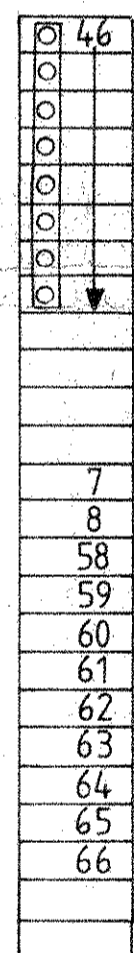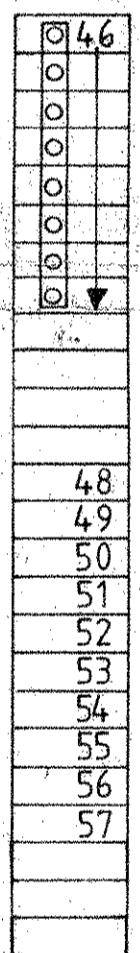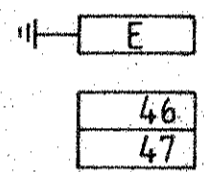

NOTE:- TUBULAR TYPE LAMPS MBC FITTING 10MM.
28V. 0.1A. (LAMP N^o 1820.)

⊙ CUSTOMERS CONNECTION TERMS. D.C. GREY 1mm² MULTI-STRAND.
⊕ MODULE INTERCONNECTION TERMS.

CABLE COLOUR:-

| AMOT CONTROLS LTD. | | TOLERANCES | | MATL. | DRWN. D.I. | TITLE |
|---|--|--------------------------|----------------------|-------|---------------|--|
| ELTON WORKS WESTERN WAY BURY ST. EDMUNDS SUFFOLK ENGLAND | | UNLESS OTHERWISE STATED: | | SPEC. | TRCD. | SCHEMATIC WIRING DIAGRAM 20 WAY LAMP UNIT ENGINE PANEL |
| DIMS IN BASIC #M. | | ± | FINISH | CHKD. | APPR. | |
| DIMS TO ONE PLACE DEC. | | ± | SPEC. | SCALE | DATE 11/11/80 | MODEL (S) |
| DIMS TO TWO PLACE DEC. | | ± | SURFACE FINISH | M/CD. | SCALE | DRG No. D/ETS 2715 sht 4 |
| ANGULAR DIMS. | | ± | REMOVE SHARP CORNERS | CAST | DATE 11/11/80 | MODEL (S) |
| RADIOI CAST | | M/CD | | | | |

| DRG No. | CHANGE |
|---------|--|
| 0 | AS DRAWN |
| 1 | NOTE ADDED TO LAMP INFO CHANNELS 2, 3, 4, 5, 8 & 10. LAMP INFO ADDED. TITLE WORDING ADDED. TERM. LAYOUT REVISED. 10% SPARE TERMS ADDED. ACT-2 was CS82-3. LOX2-3 CONNECTED TO TERMS 30 & 31. |
| 2 | ONE EXTRA SPARE TERM. ADDED TO EACH BLOCK. ACT-2 WOULD SHOW AS OTHER CONTACT JUMPER BAR ON TERM. BLOCK WAS NOT SHOWN. |
| 3 | AS MADE 26/6/81 |

#38