

#146
177 NOV 1988



MAIN CONTRACTOR APE-CROSSLEY LTD	PROJECT MAJURO POWER STATION
PRIME CONTRACTOR PSECO INTERNATIONAL POWER SYSTEMS LTD 85-87 JERMYN STREET LONDON SW1Y 6DD	CLIENT THE GOVERNMENT OF THE MARSHALL ISLANDS
SCALE 1/250	APPROVED
DRAWN J.P.S.	CHECKED J.P.S.
TITLE ENGINEERING - HALL GROUND FLOOR EARTHING ARRANGEMENT	W.H. SMITH & CO ELECTRICAL ENGINEERS LTD
DRAWING No WHS/333	SHT 1 of 2

KEY

- 50mm x 6mm COPPER EARTH TRIBE
- 15mm x 3mm COPPER EARTH TRIBE
- 70mm² SC PVC COPPER EARTH CABLE
- TWISTED/BULLETED CONNECTION

NOTES

1. EARTH TAPES TO BE SUPPORTED BY NON METALLIC DC CLIPS AT 800mm INTERVALS APPROX. (PURSE TYPE P38).

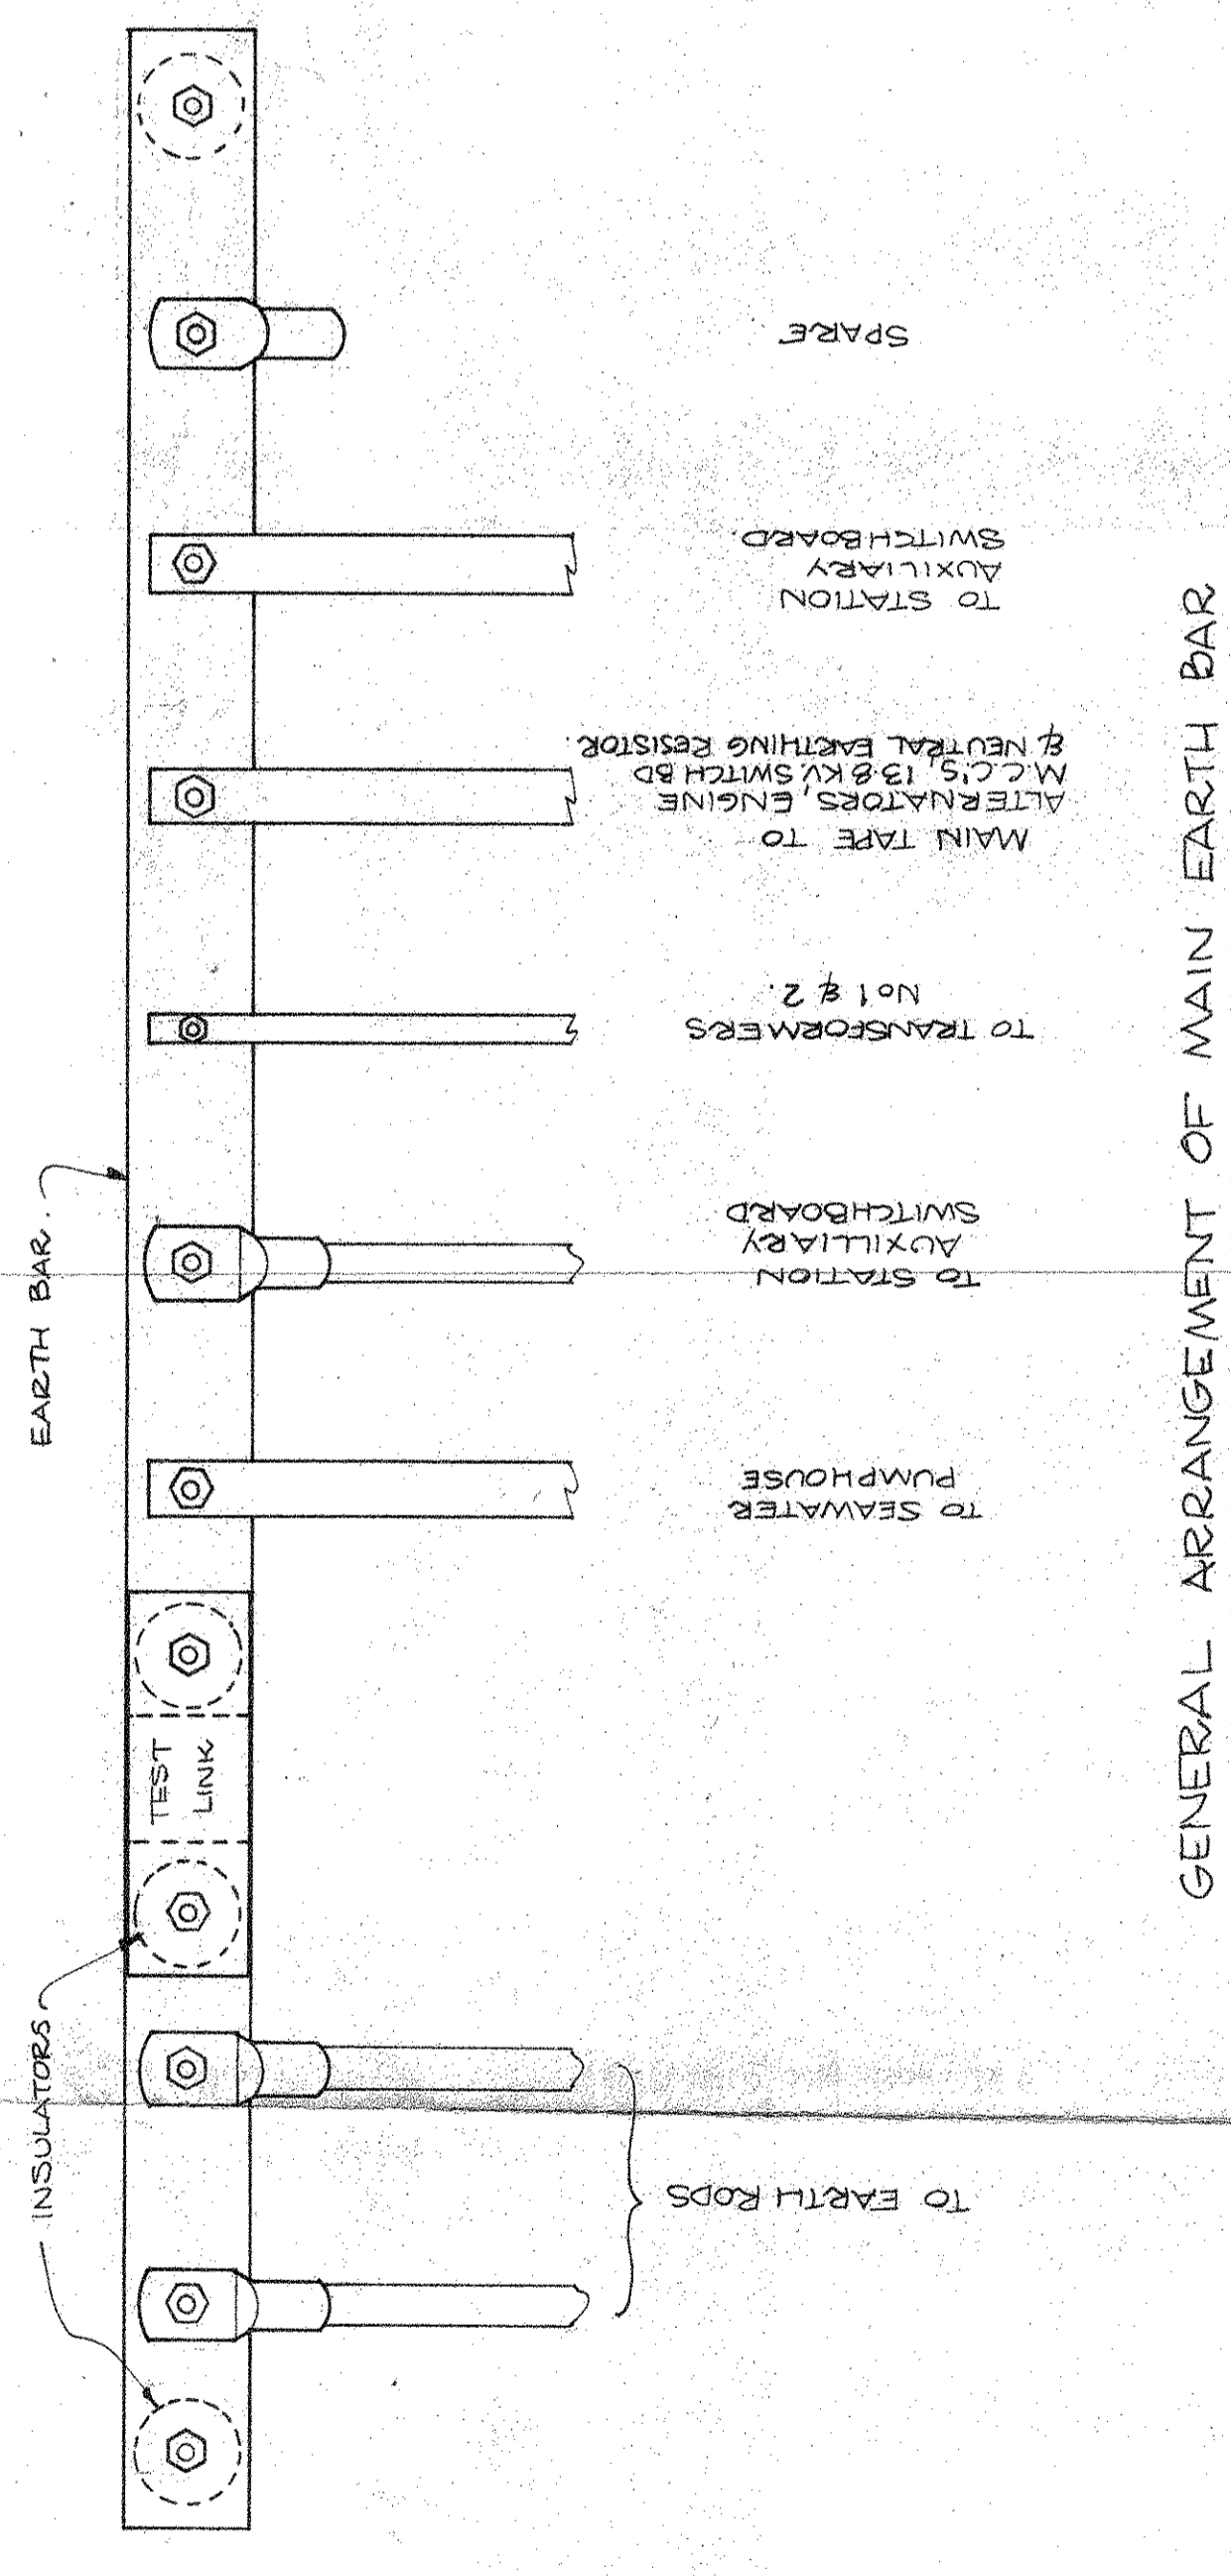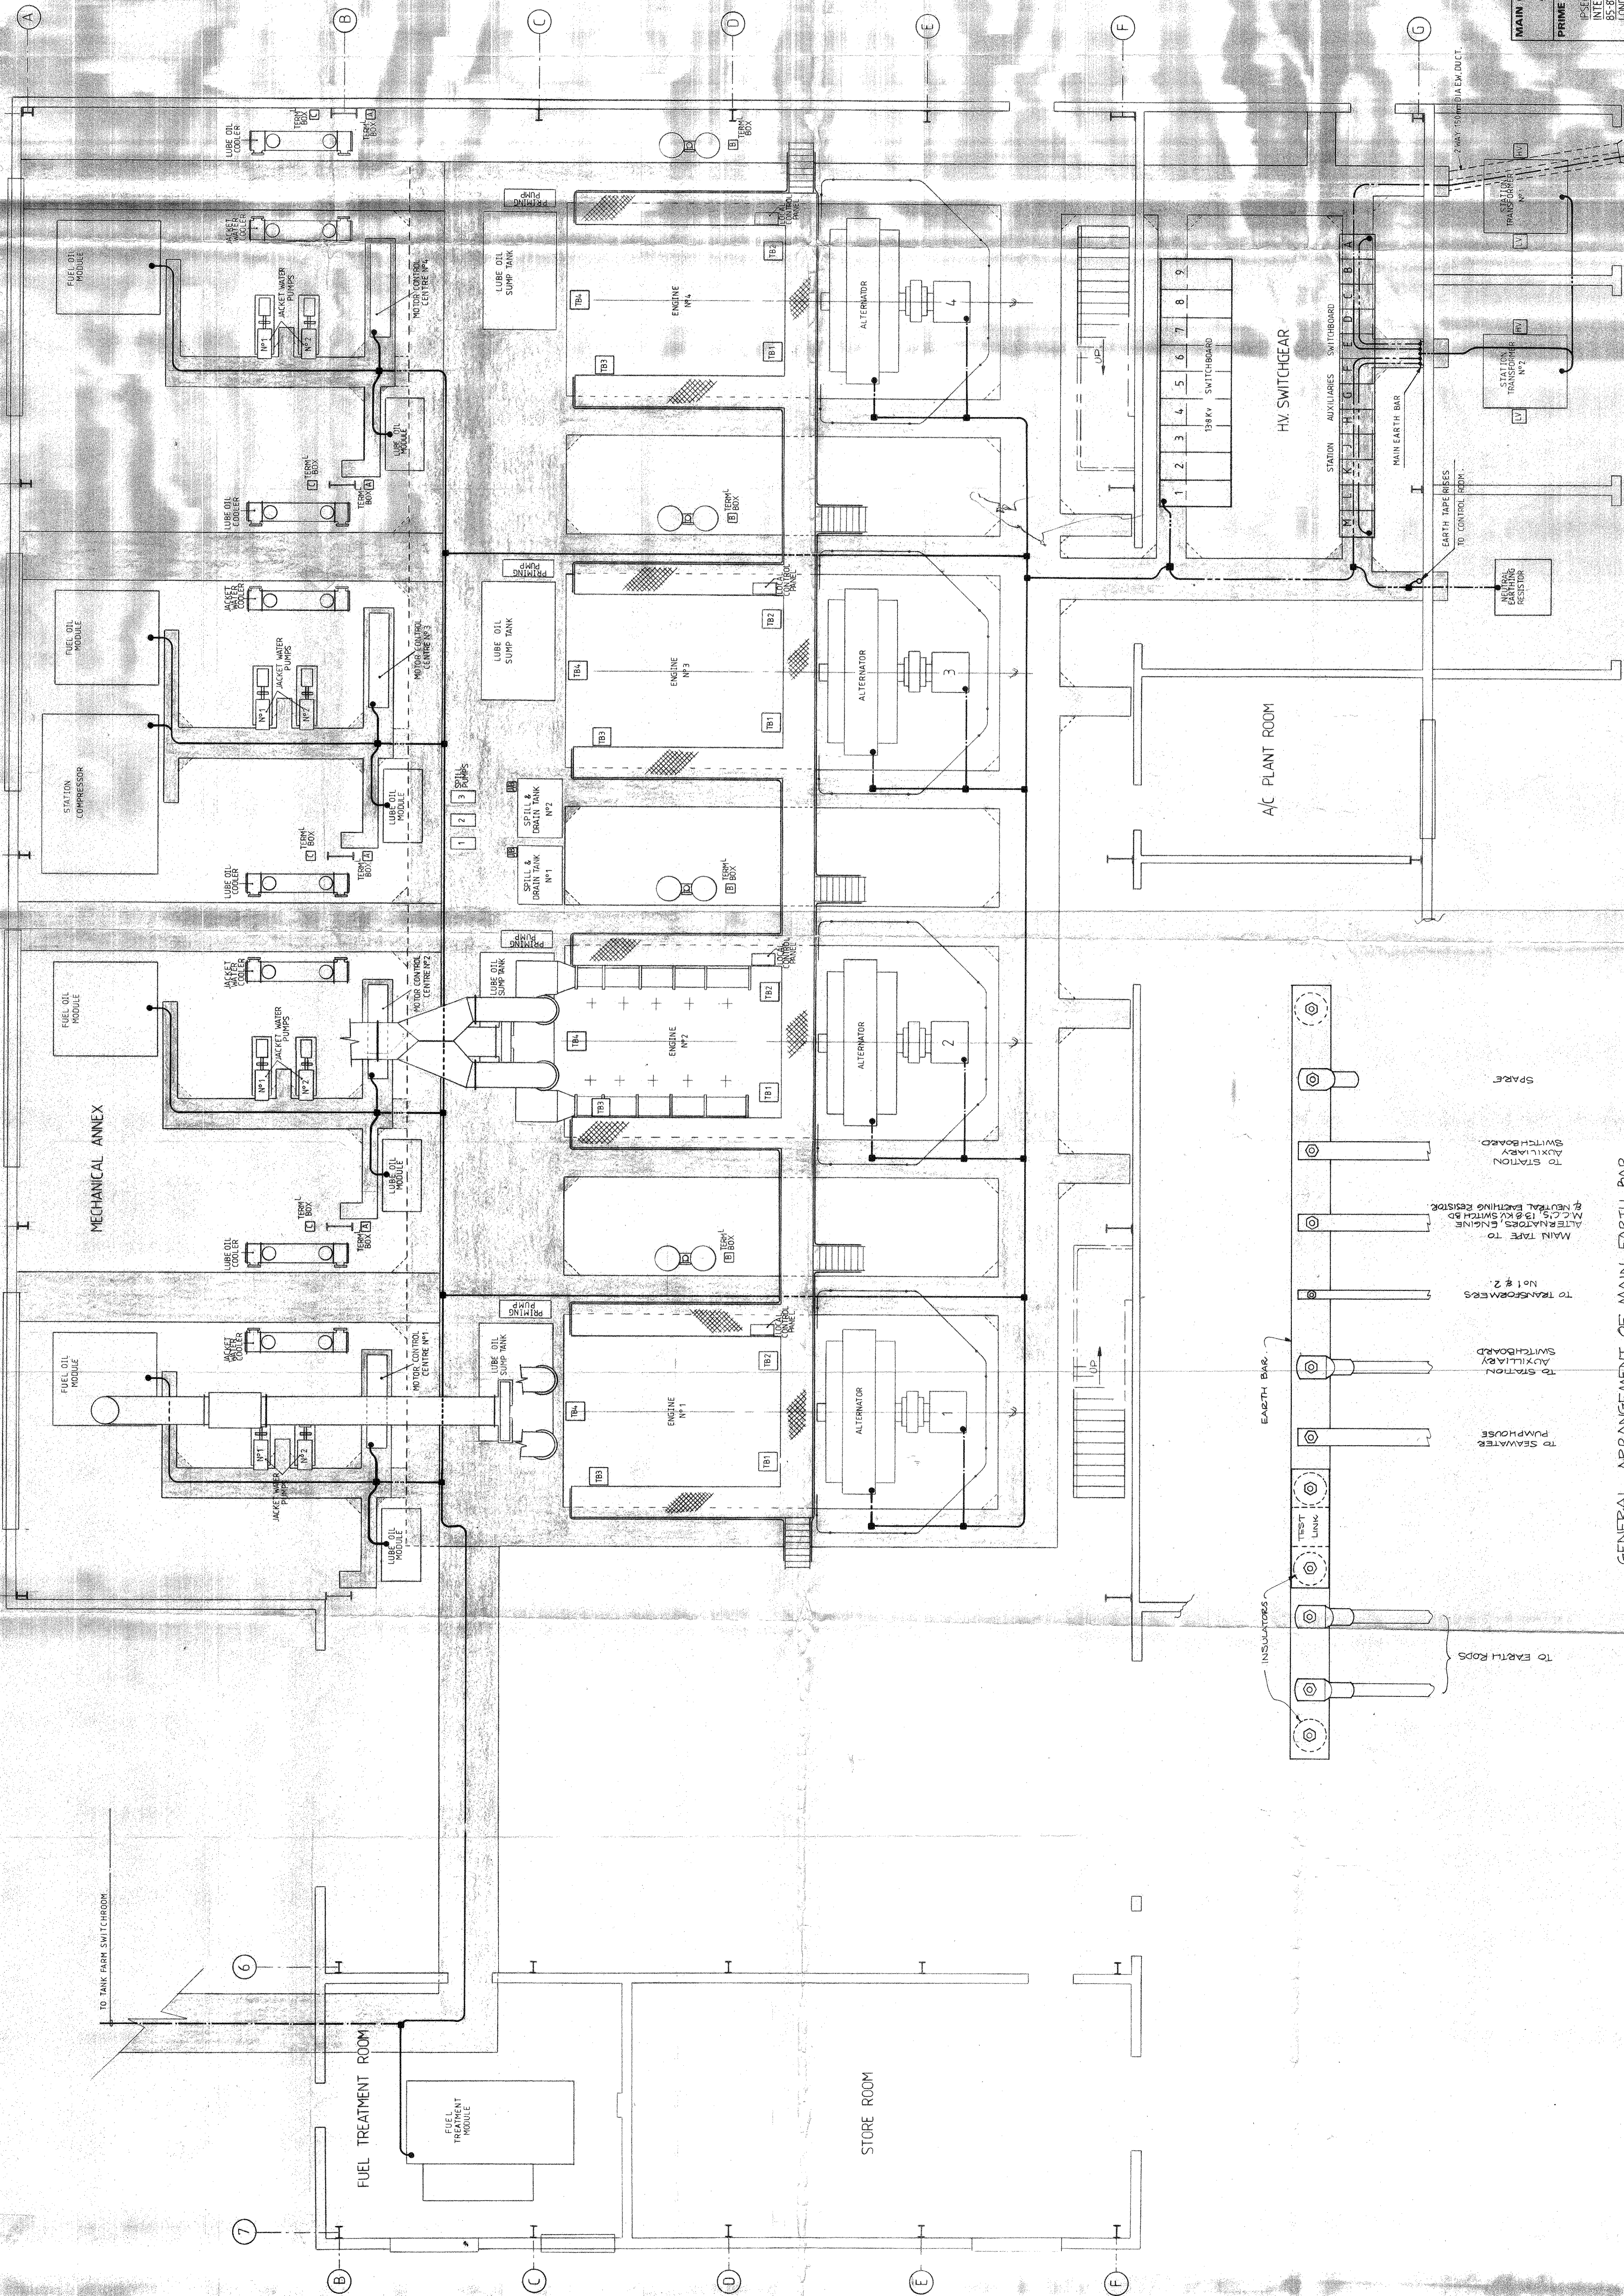

DESIGNED	BY	DATE	CHECKED	DATE
DRAWN	BY	DATE	APPROVED	DATE
REVISION	NO.	DESCRIPTION	DATE	BY
1		ISSUED FOR TENDER		
2		ISSUED FOR CONSTRUCTION		