

PARTS LIST



DIMENSIONS IN MILLIMETRES  
(INCHES IN BRACKETS)

IF IN DOUBT ASK  
THIRD ANGLE PROJECTION

TERMINAL LAYOUT:

DRG No. **C/ETS 2728**

ISSUE & DATE	CHANGE	
0.	AS DRAWN	
1.	CUSTOMERS SUPPLY CHANGED	A
	RMF RELAY C/O	
	CIRCUIT ADPCE	
	NOTE & 10% SPARE	
	TERM'S ADDED	
	TERM. LAYOUT MODIFIED	
2.	ANNUN SUPPLY OUTPUT	
	DRG NO. CORRECT	
5/5/81	SEC VOLT OF TRANS ADDED	
3.	MOD TO MARKED	B
	LIP PRINTS	
8/6/81	DURING PRE-TEST	
"	AS MADE	
	29/6/81	

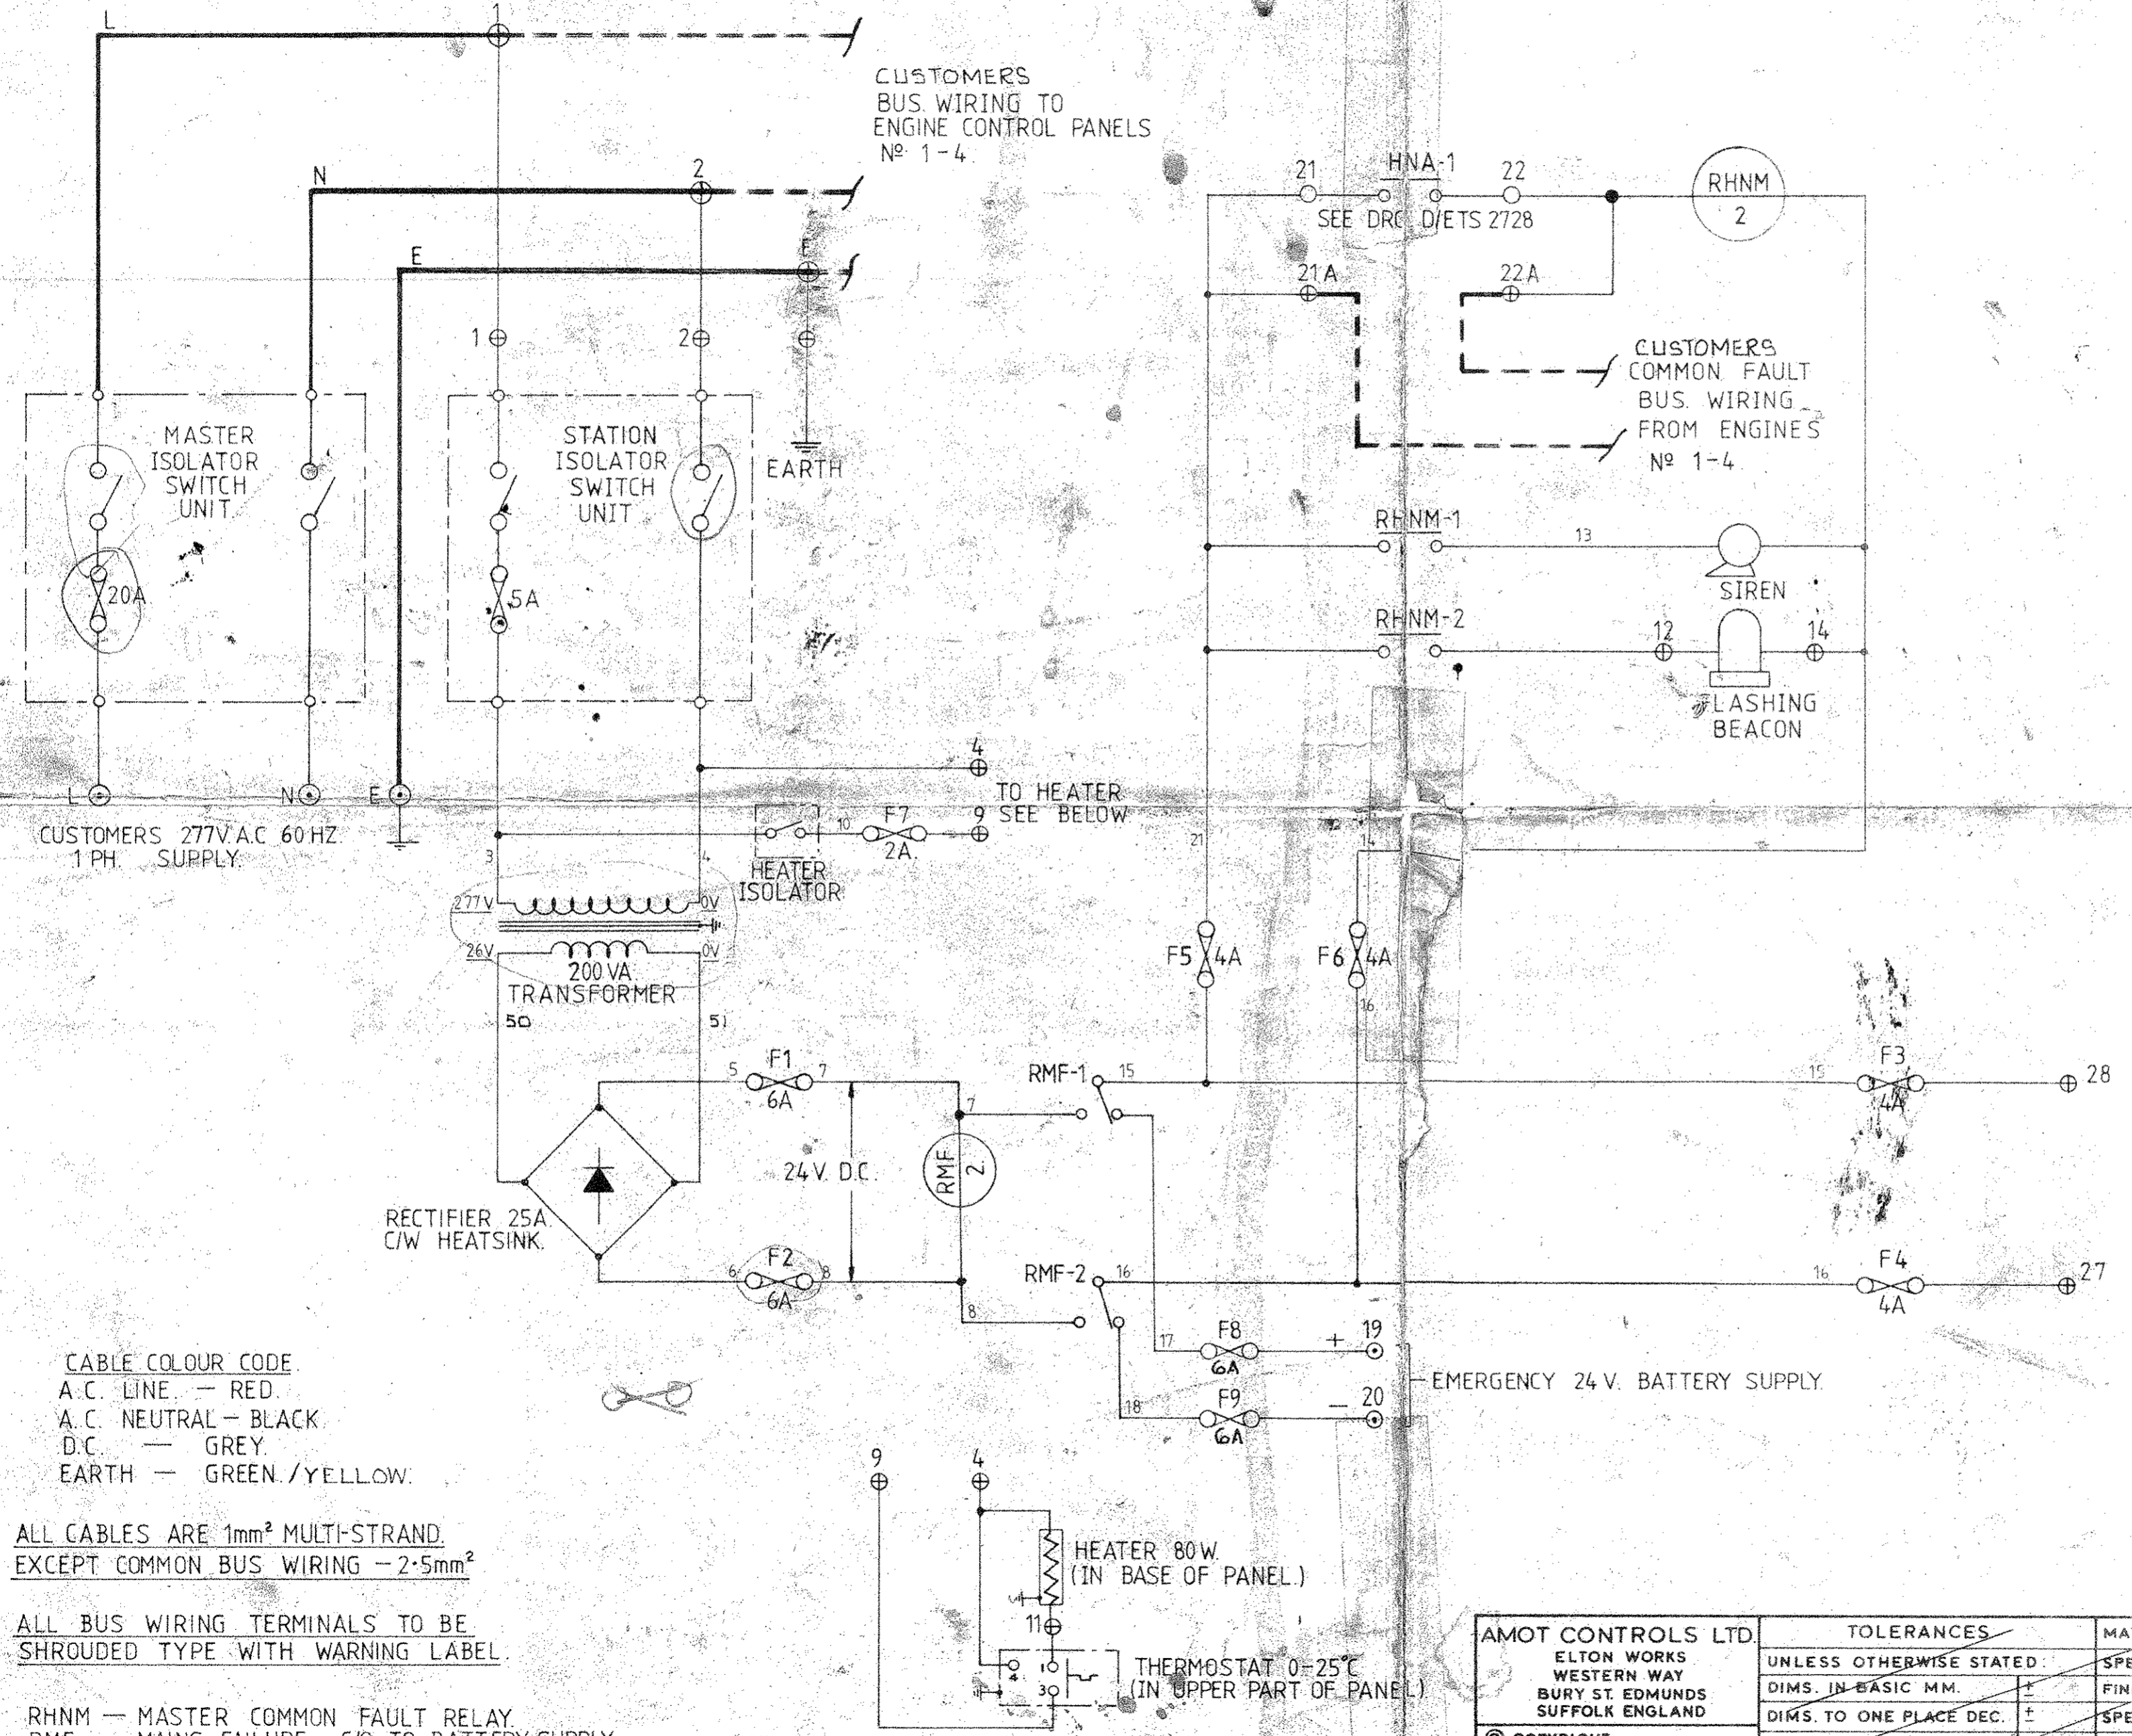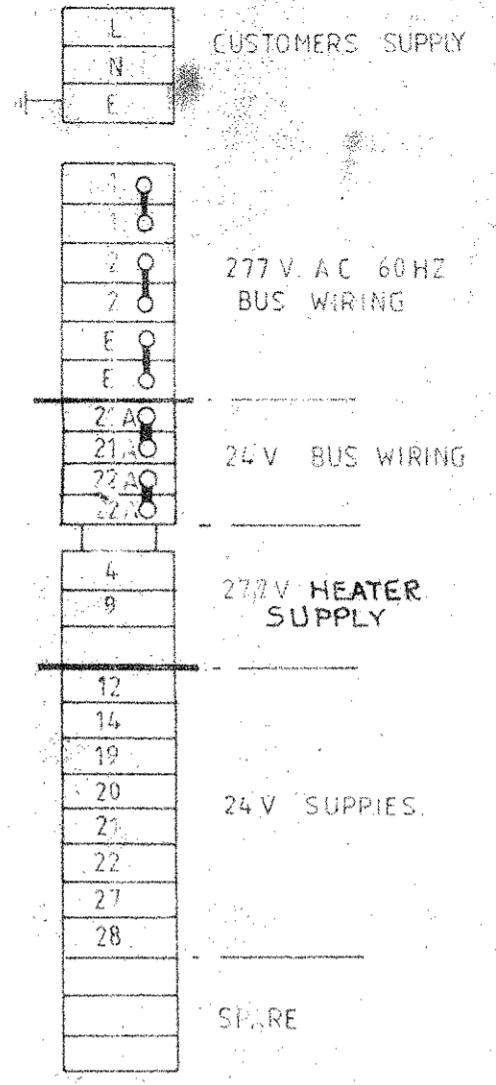

CABLE COLOUR CODE  
A.C. LINE - RED.  
A.C. NEUTRAL - BLACK  
D.C. - GREY.  
EARTH - GREEN/YELLOW.

ALL CABLES ARE 1mm<sup>2</sup> MULTI-STRAND EXCEPT COMMON BUS WIRING - 2.5mm<sup>2</sup>

ALL BUS WIRING TERMINALS TO BE SHROUDED TYPE WITH WARNING LABEL.

RHNM - MASTER COMMON FAULT RELAY  
RMF - MAINS FAILURE - C/O TO BATTERY SUPPLY.

NOTE:- SUPPLY OFF RELAYS DE-ENERGISED.

AMOT CONTROLS LTD. ELTON WORKS WESTERN WAY BURY ST. EDMUNDS SUFFOLK ENGLAND	TOLERANCES	MATL.	DRWN. D/H	TITLE
	UNLESS OTHERWISE STATED:	SPEC.	TRCD.	STATION PANEL POWER
	DIMS. IN BASIC MM. ±	FINISH	CHKD.	SUPPLY AND COMMON
	DIMS. TO ONE PLACE DEC. ±	SPEC.	APPR.	FAULT WIRING DIAGRAM
	DIMS TO TWO PLACE DEC. ±	SURFACE M/CD	SCALE	
	ANGULAR DIMS. ±	FINISH CAST	DATE	
	RADII CAST: M/CD	REMOVE SHARP CORNERS	MODEL(S)	DRG No. <b>C/ETS 2728</b>

#33