




SECTION A-A

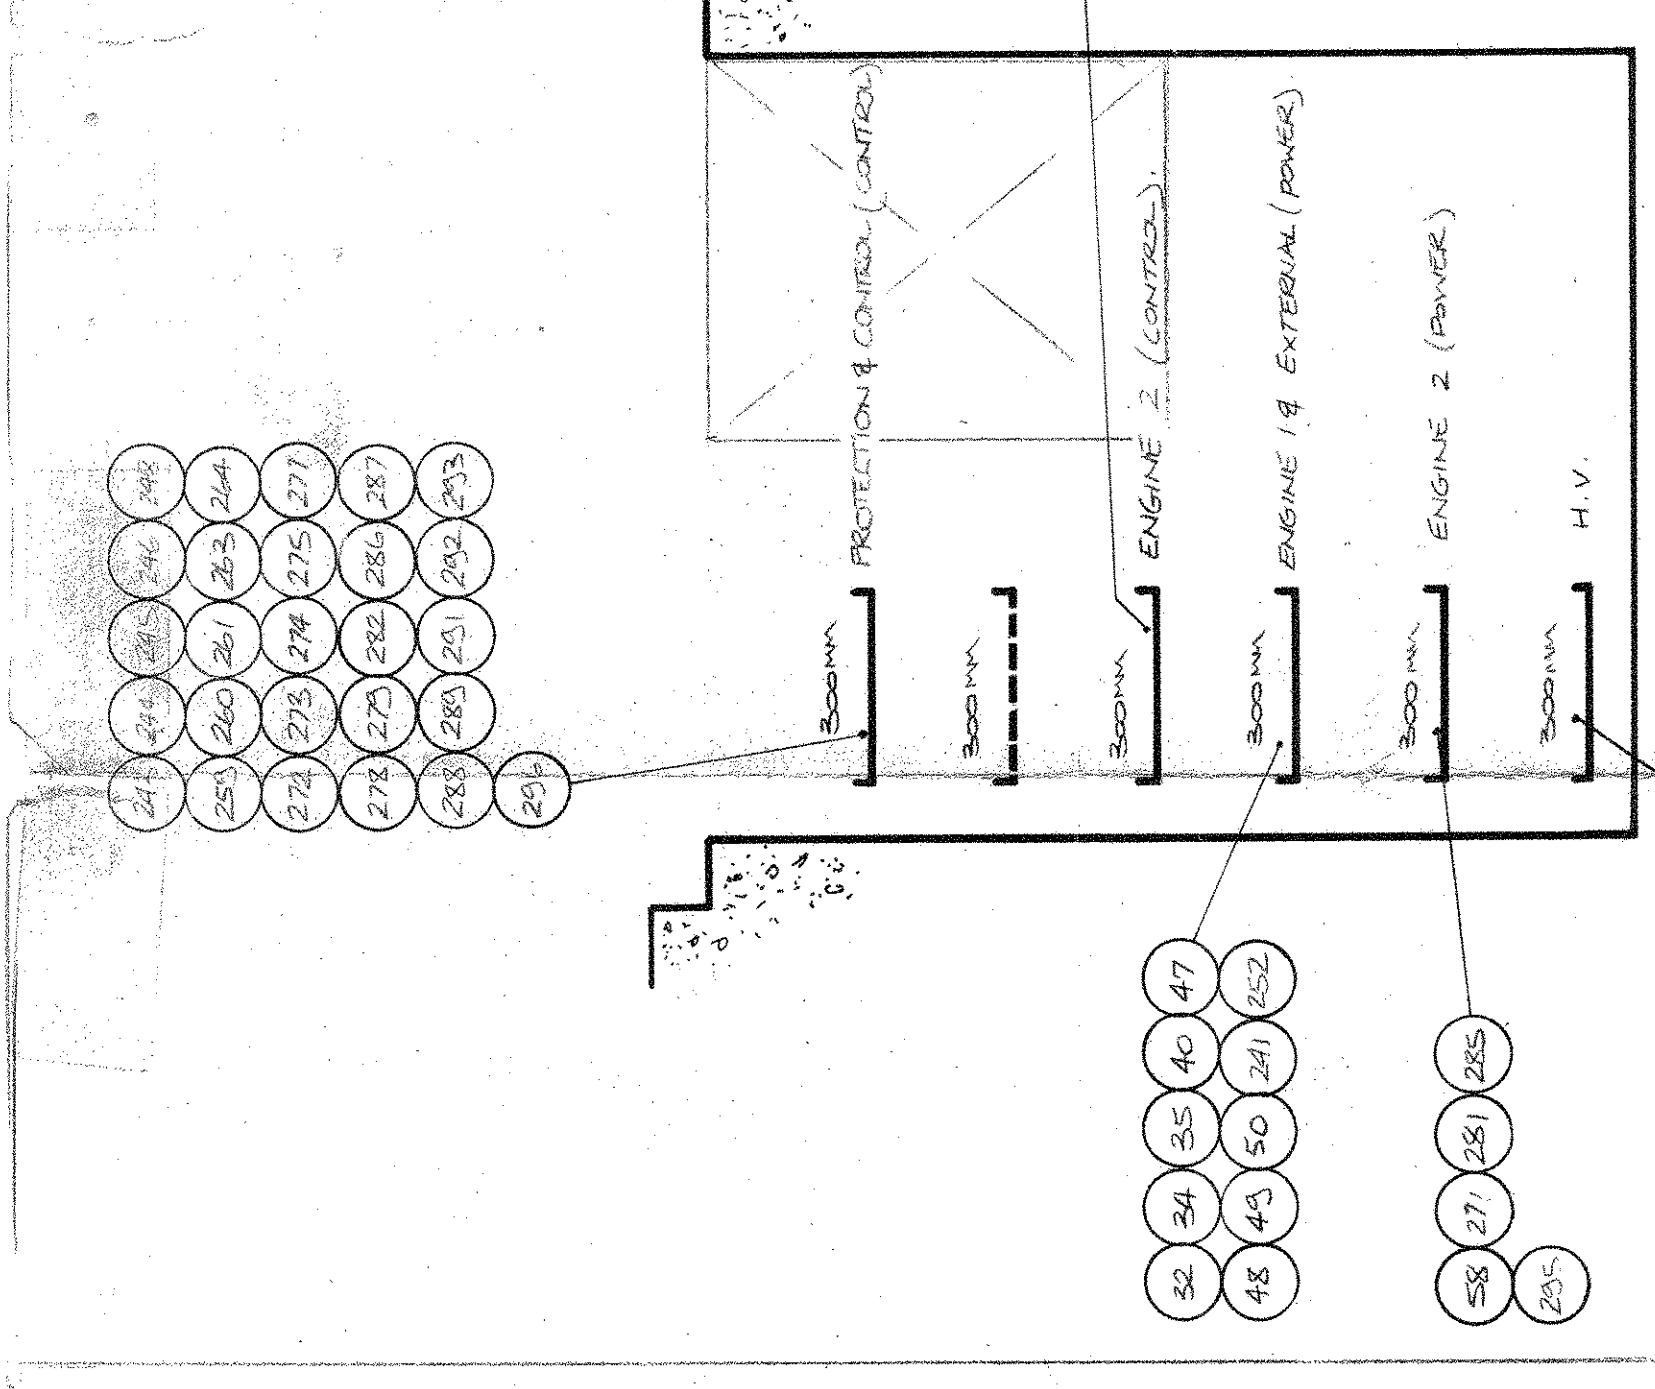


SECTION B-B

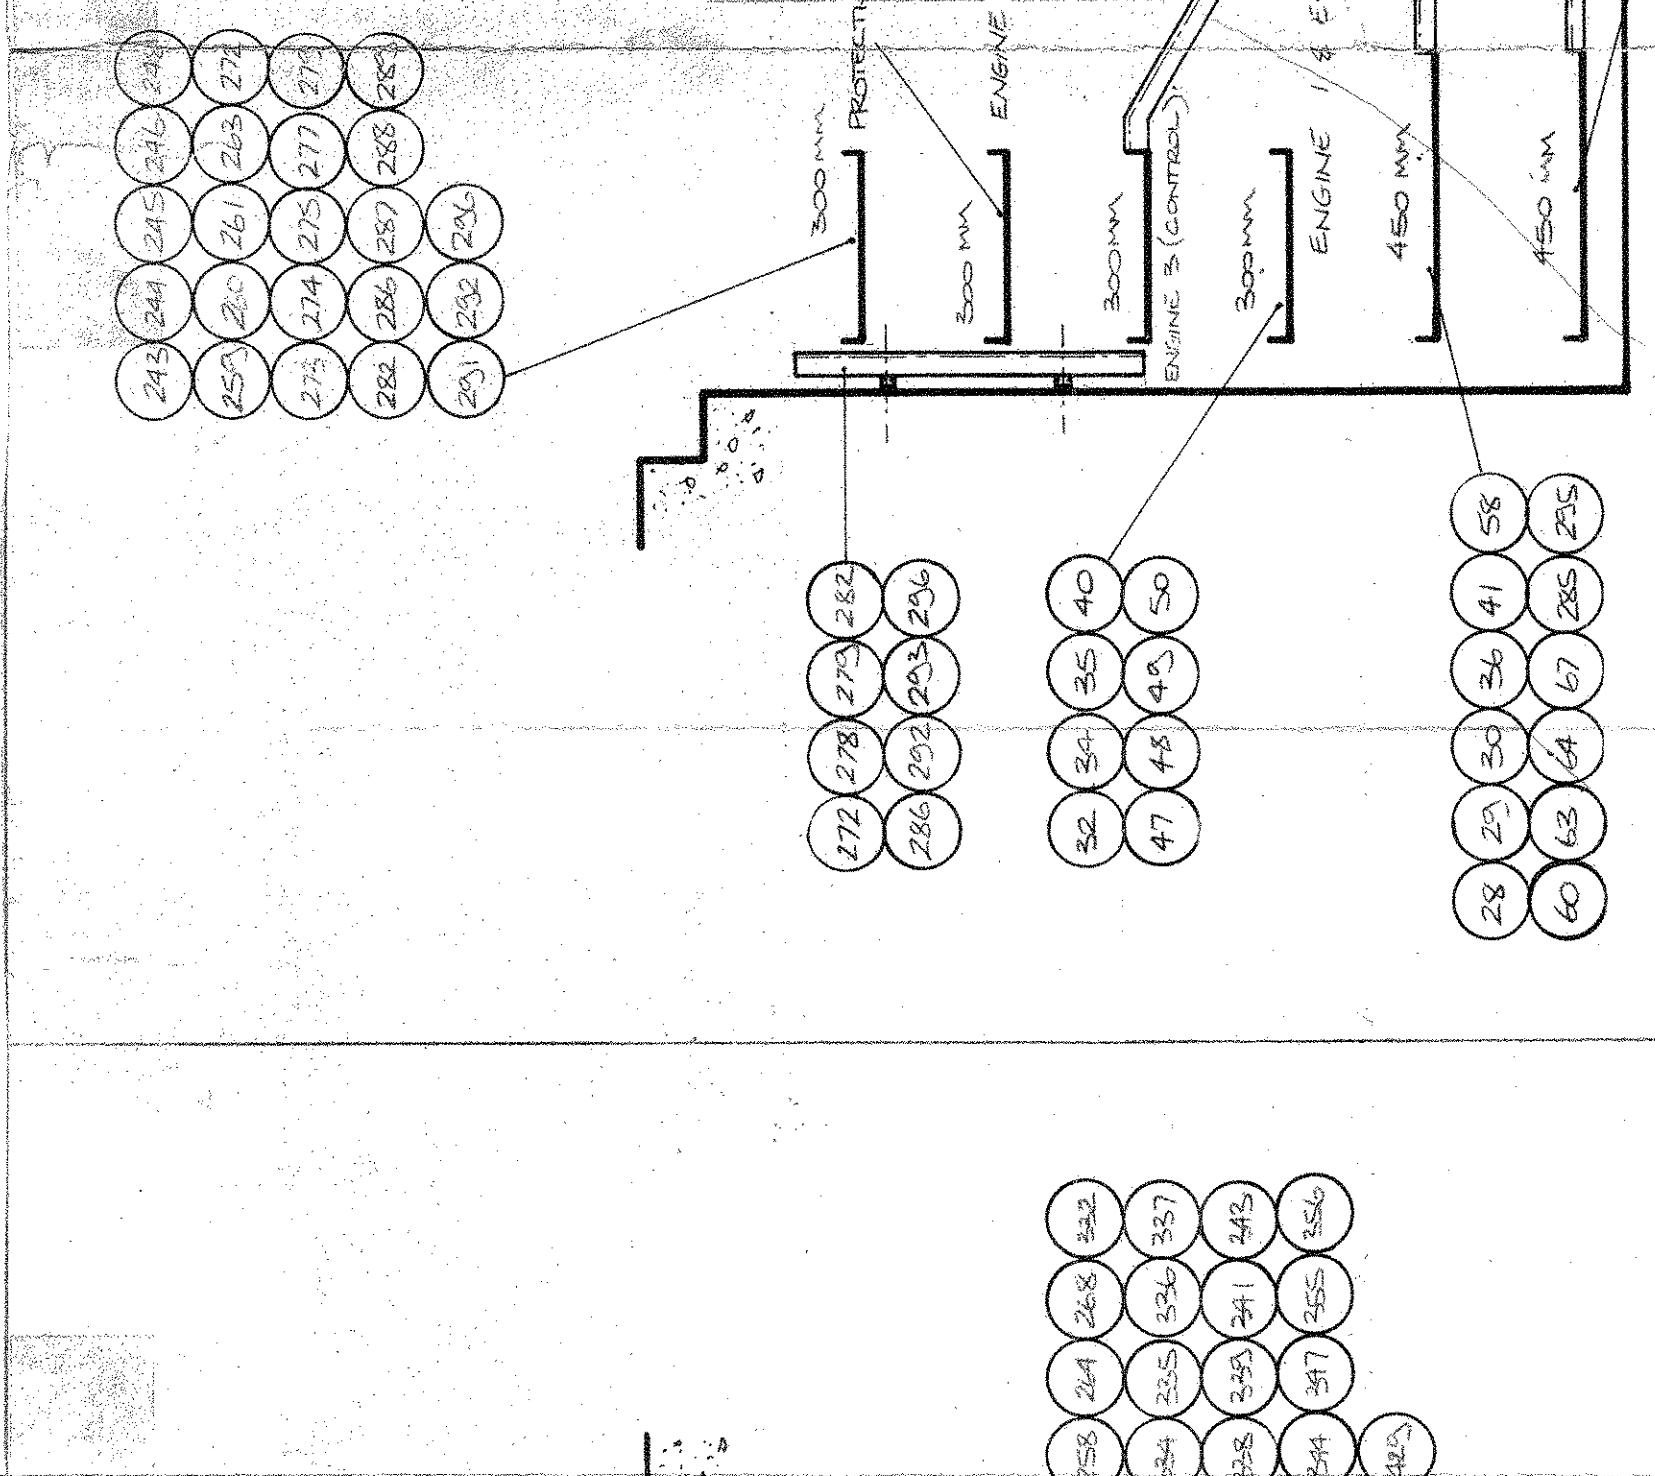


SECTION C-C

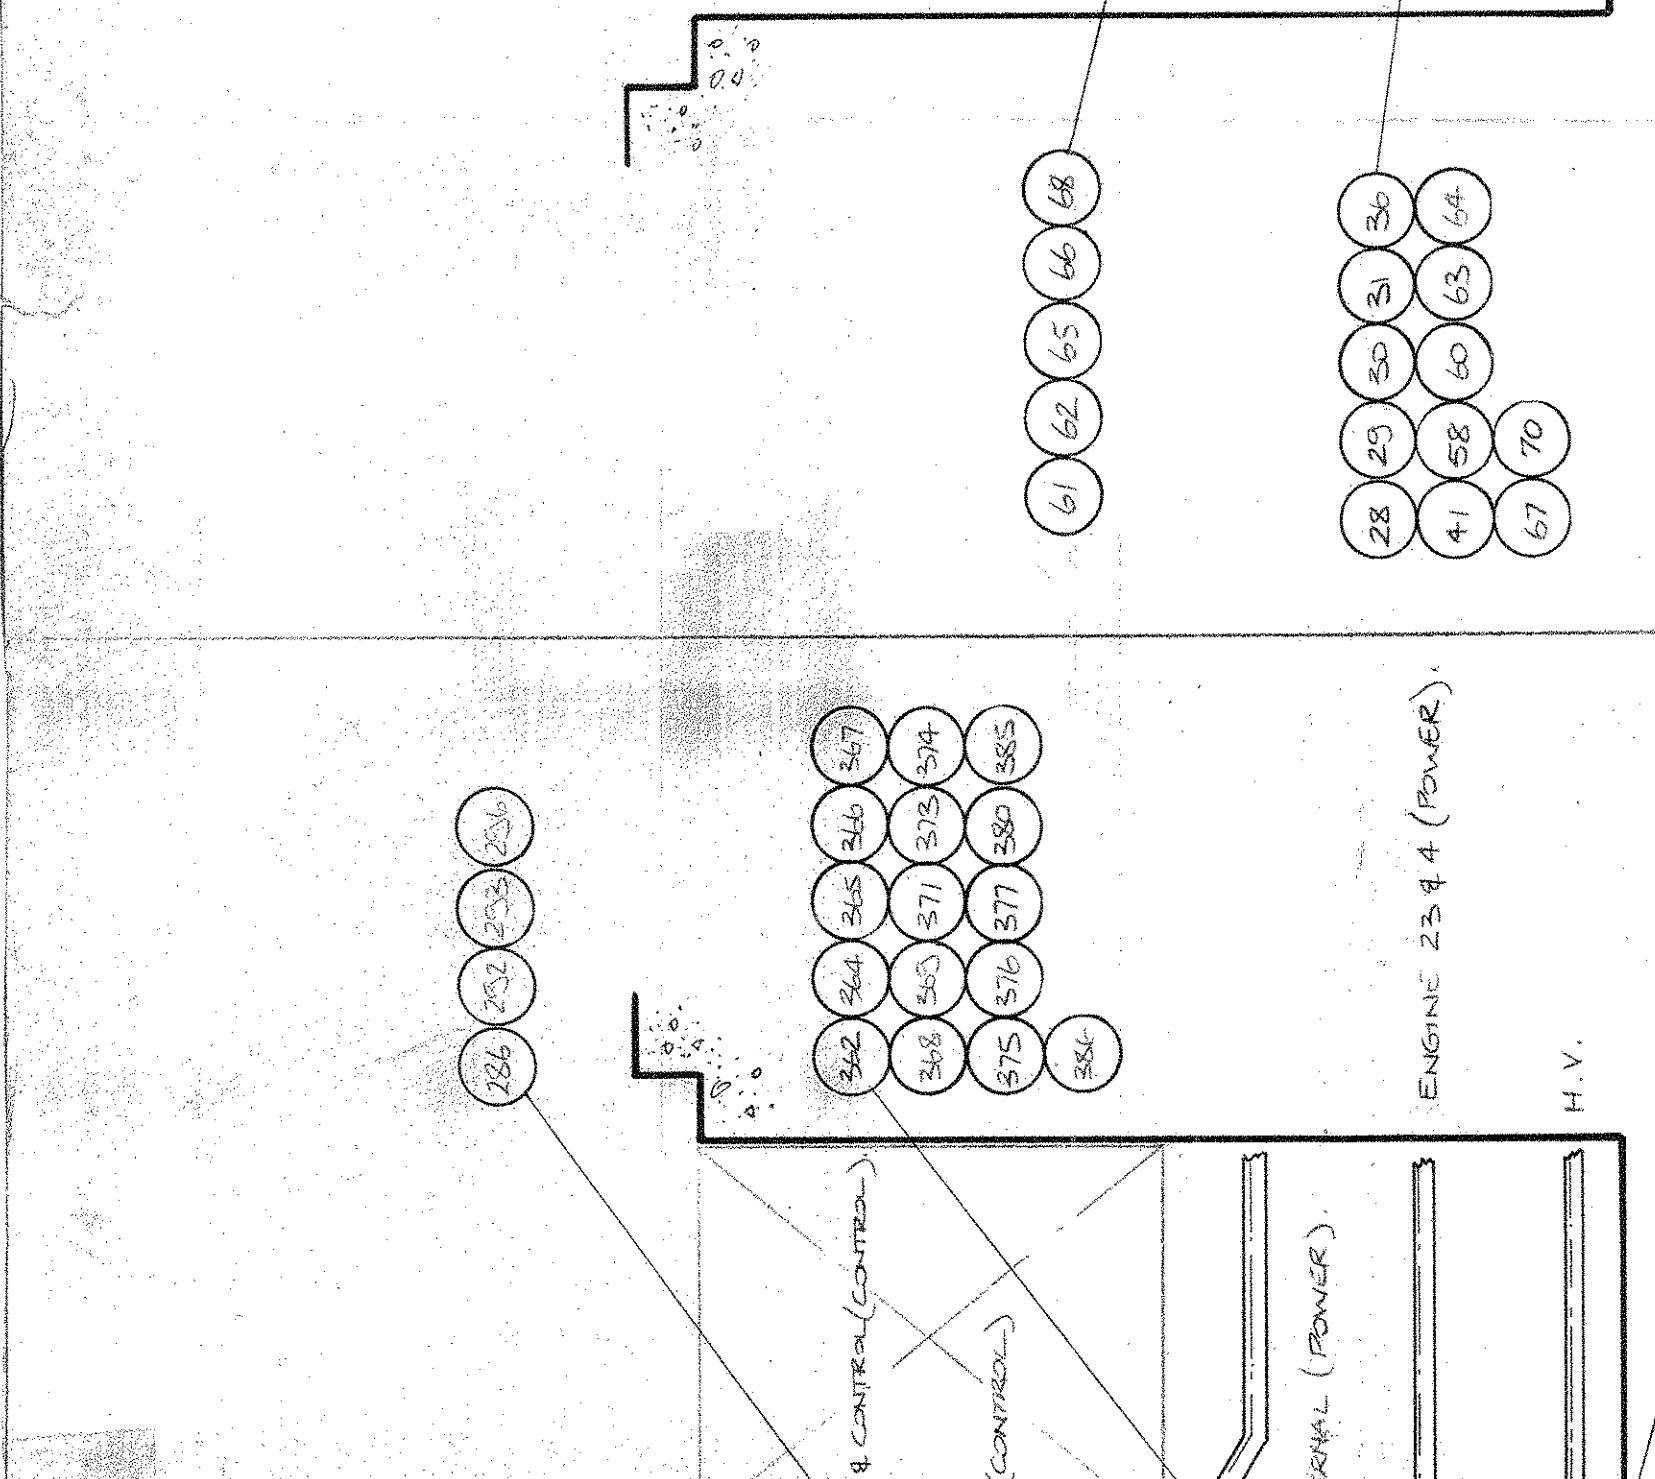


SECTION D-D

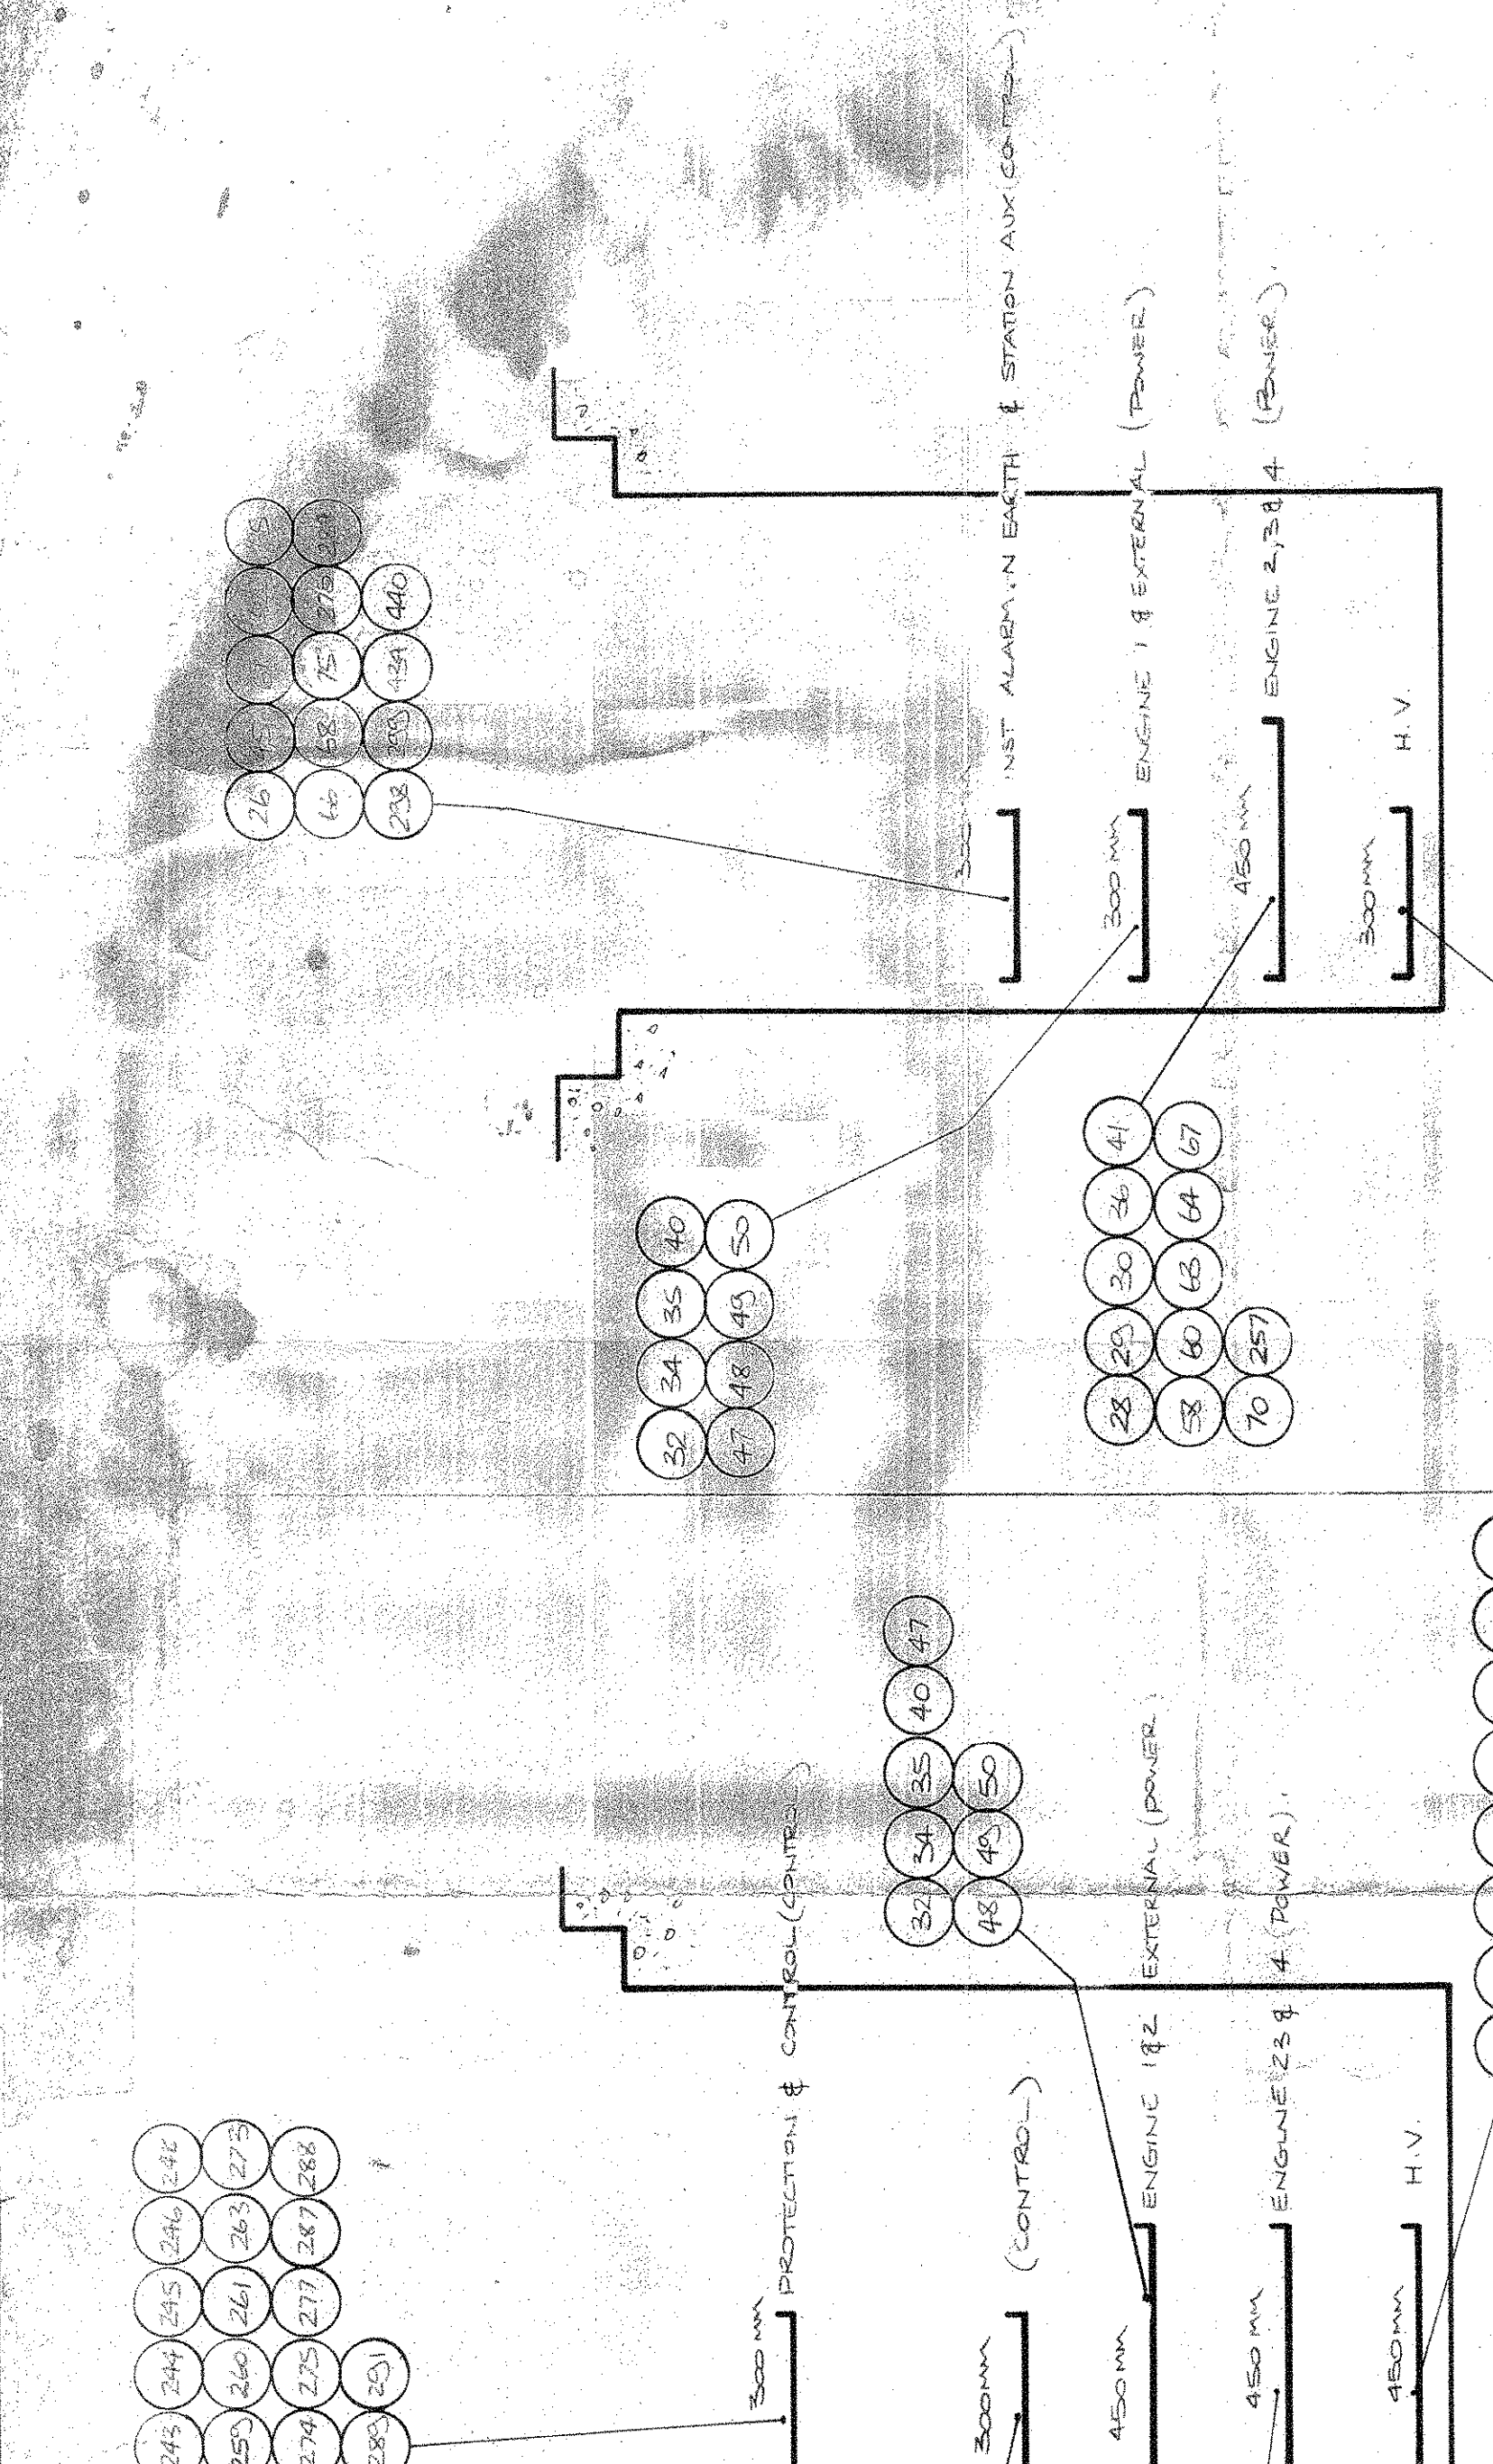


SECTION E-E

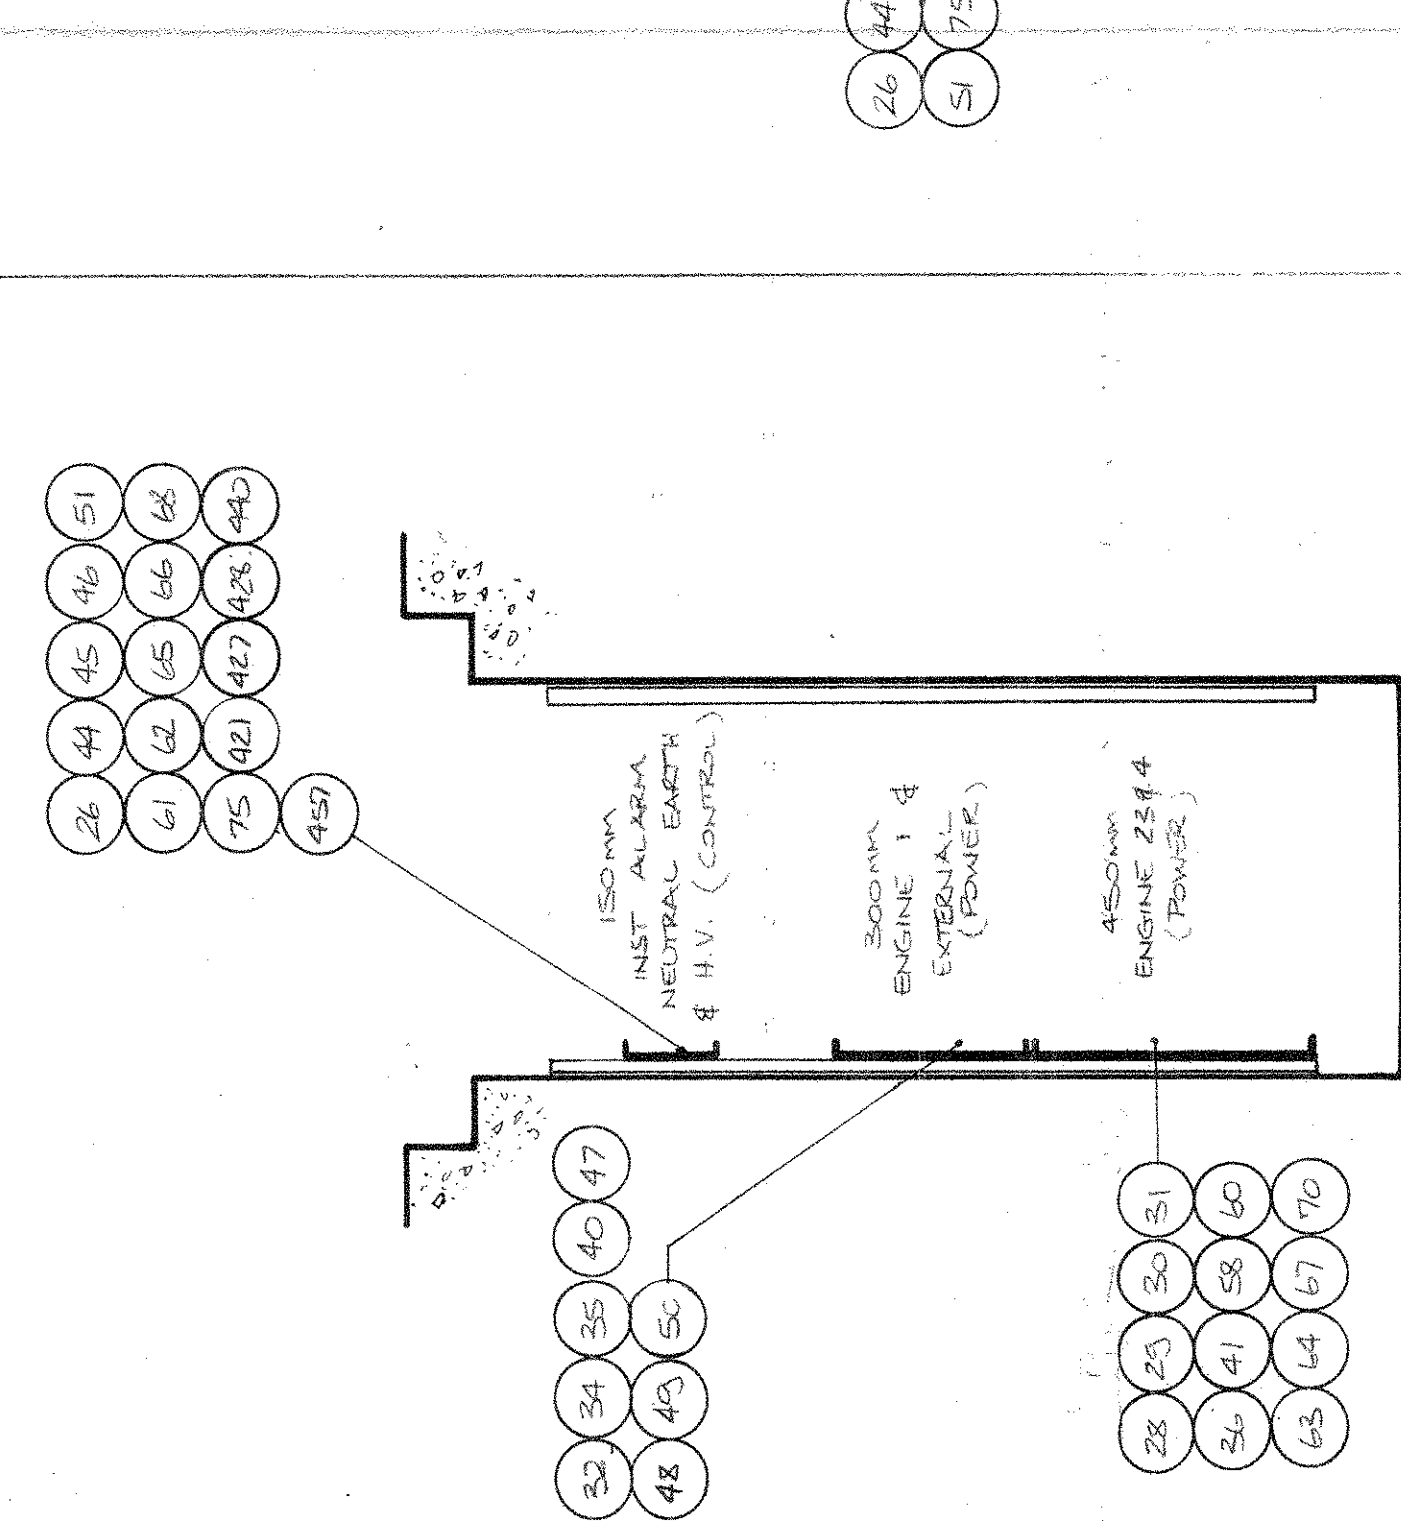


SECTION F-F

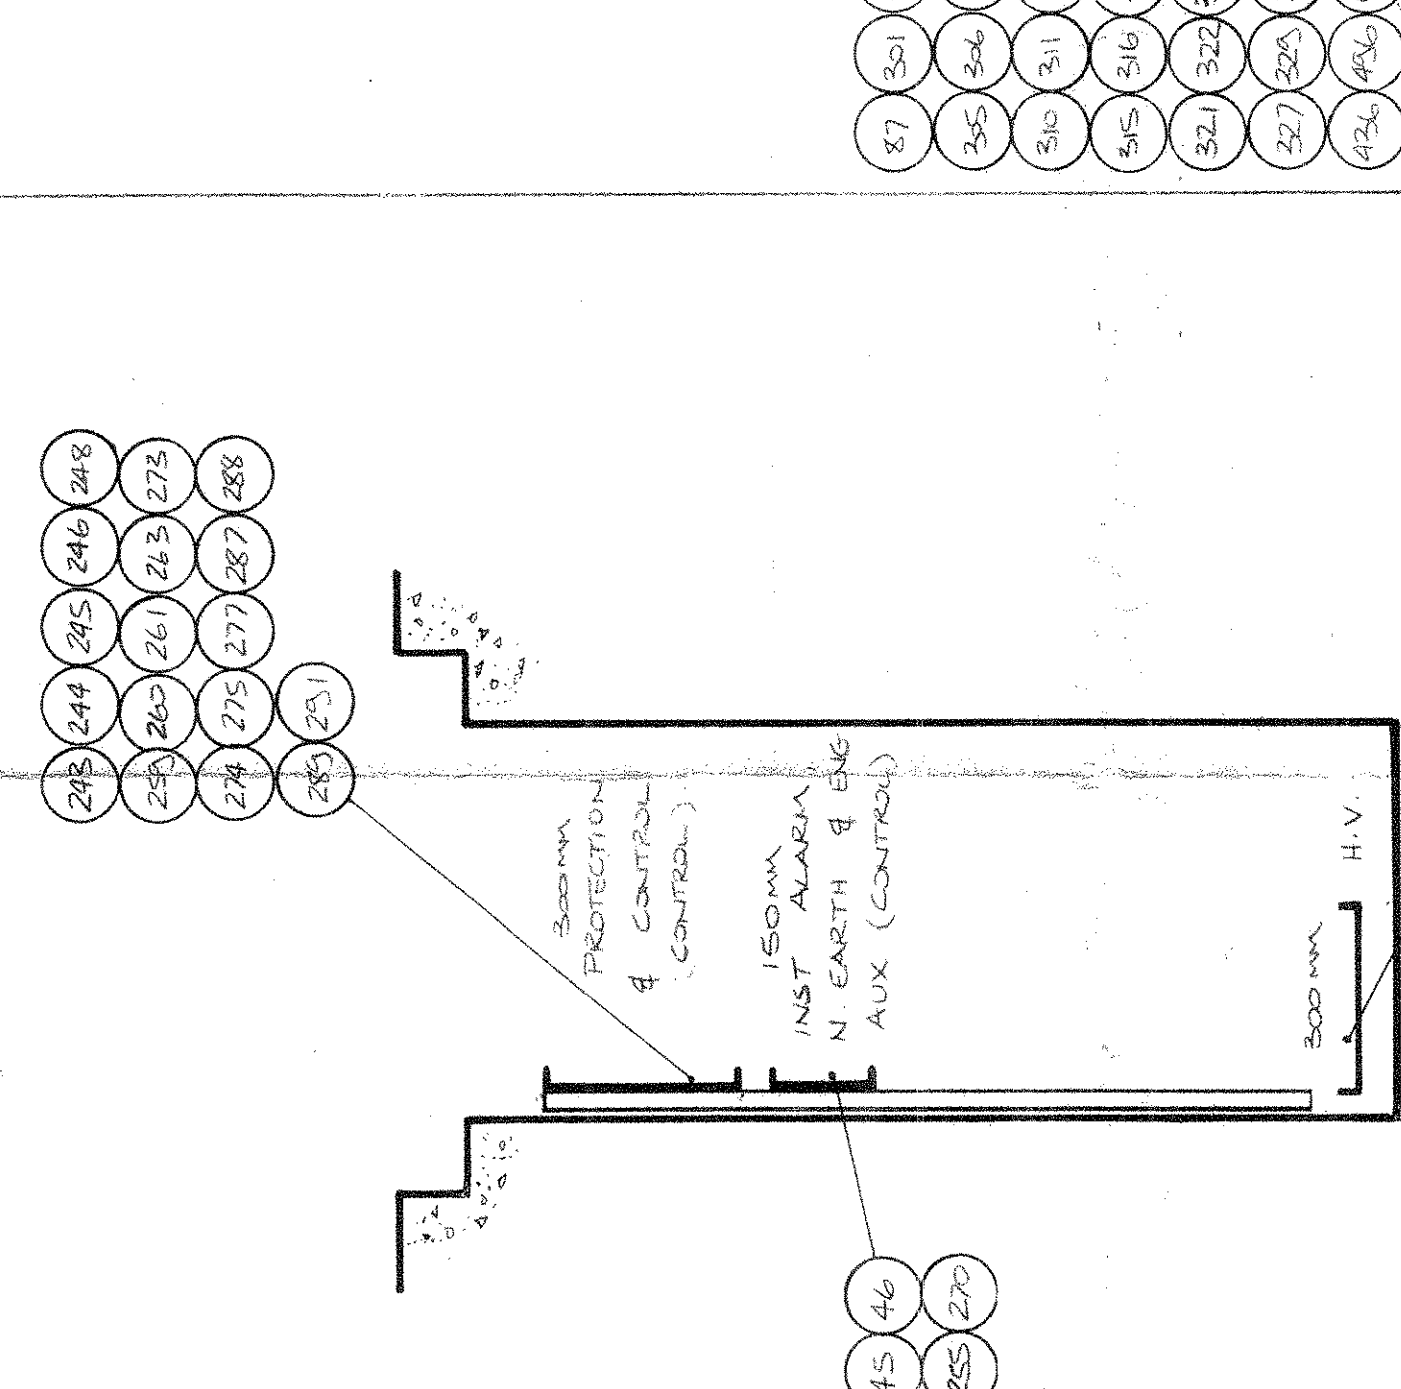


SECTION G-G

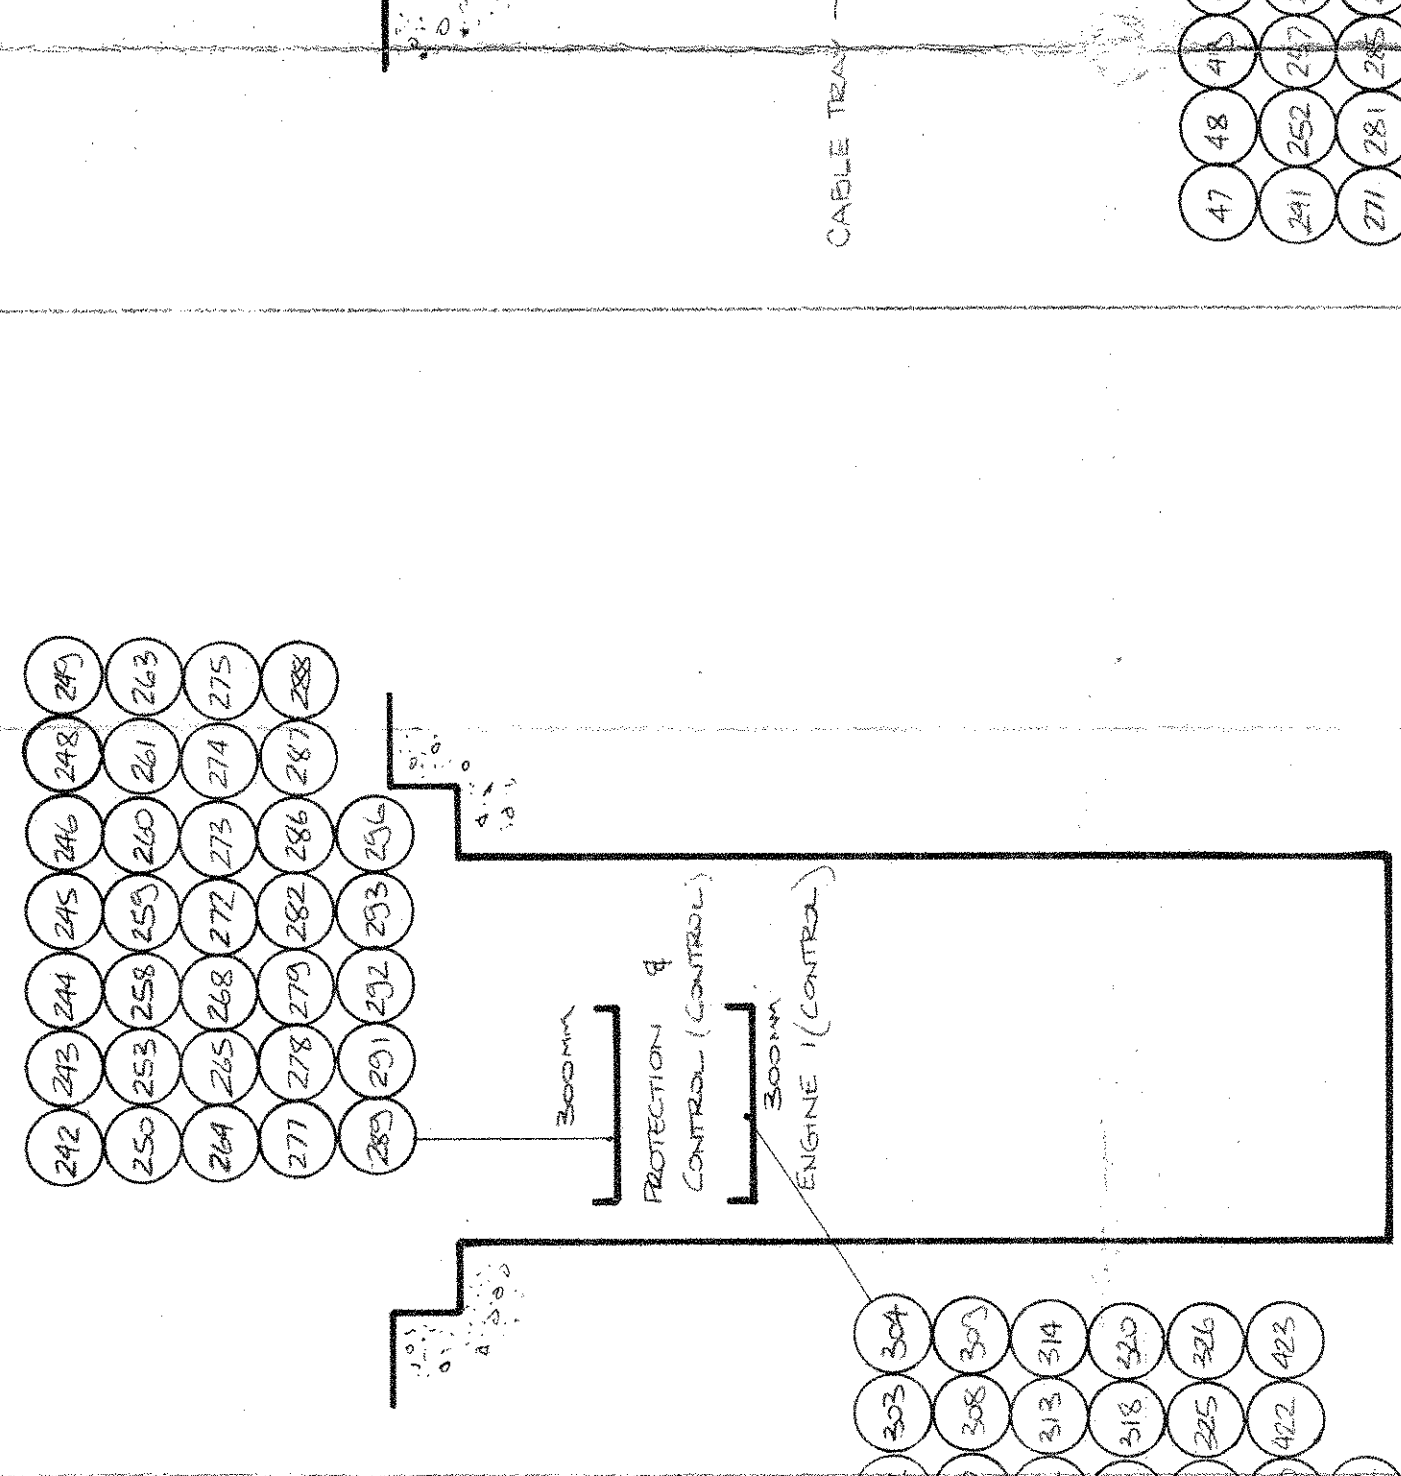

SECTION H-H

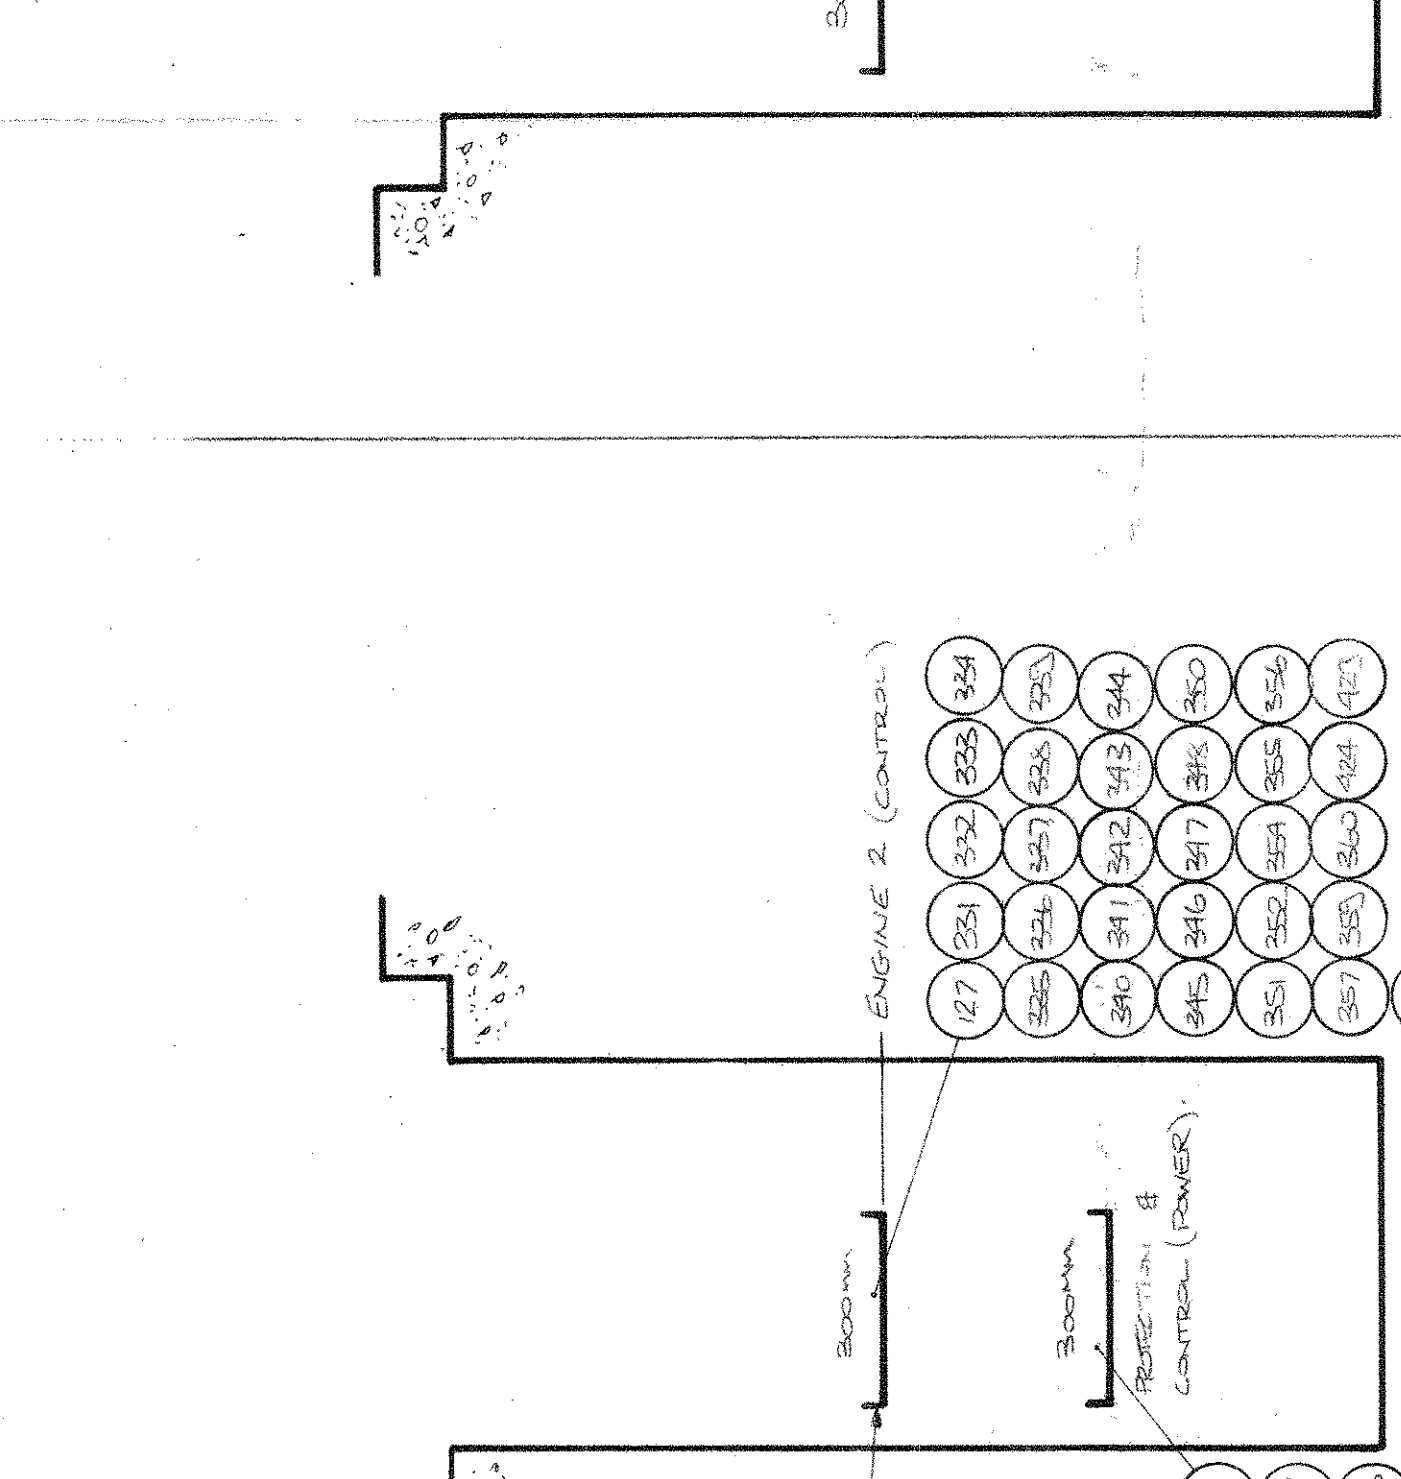


SECTION J-J

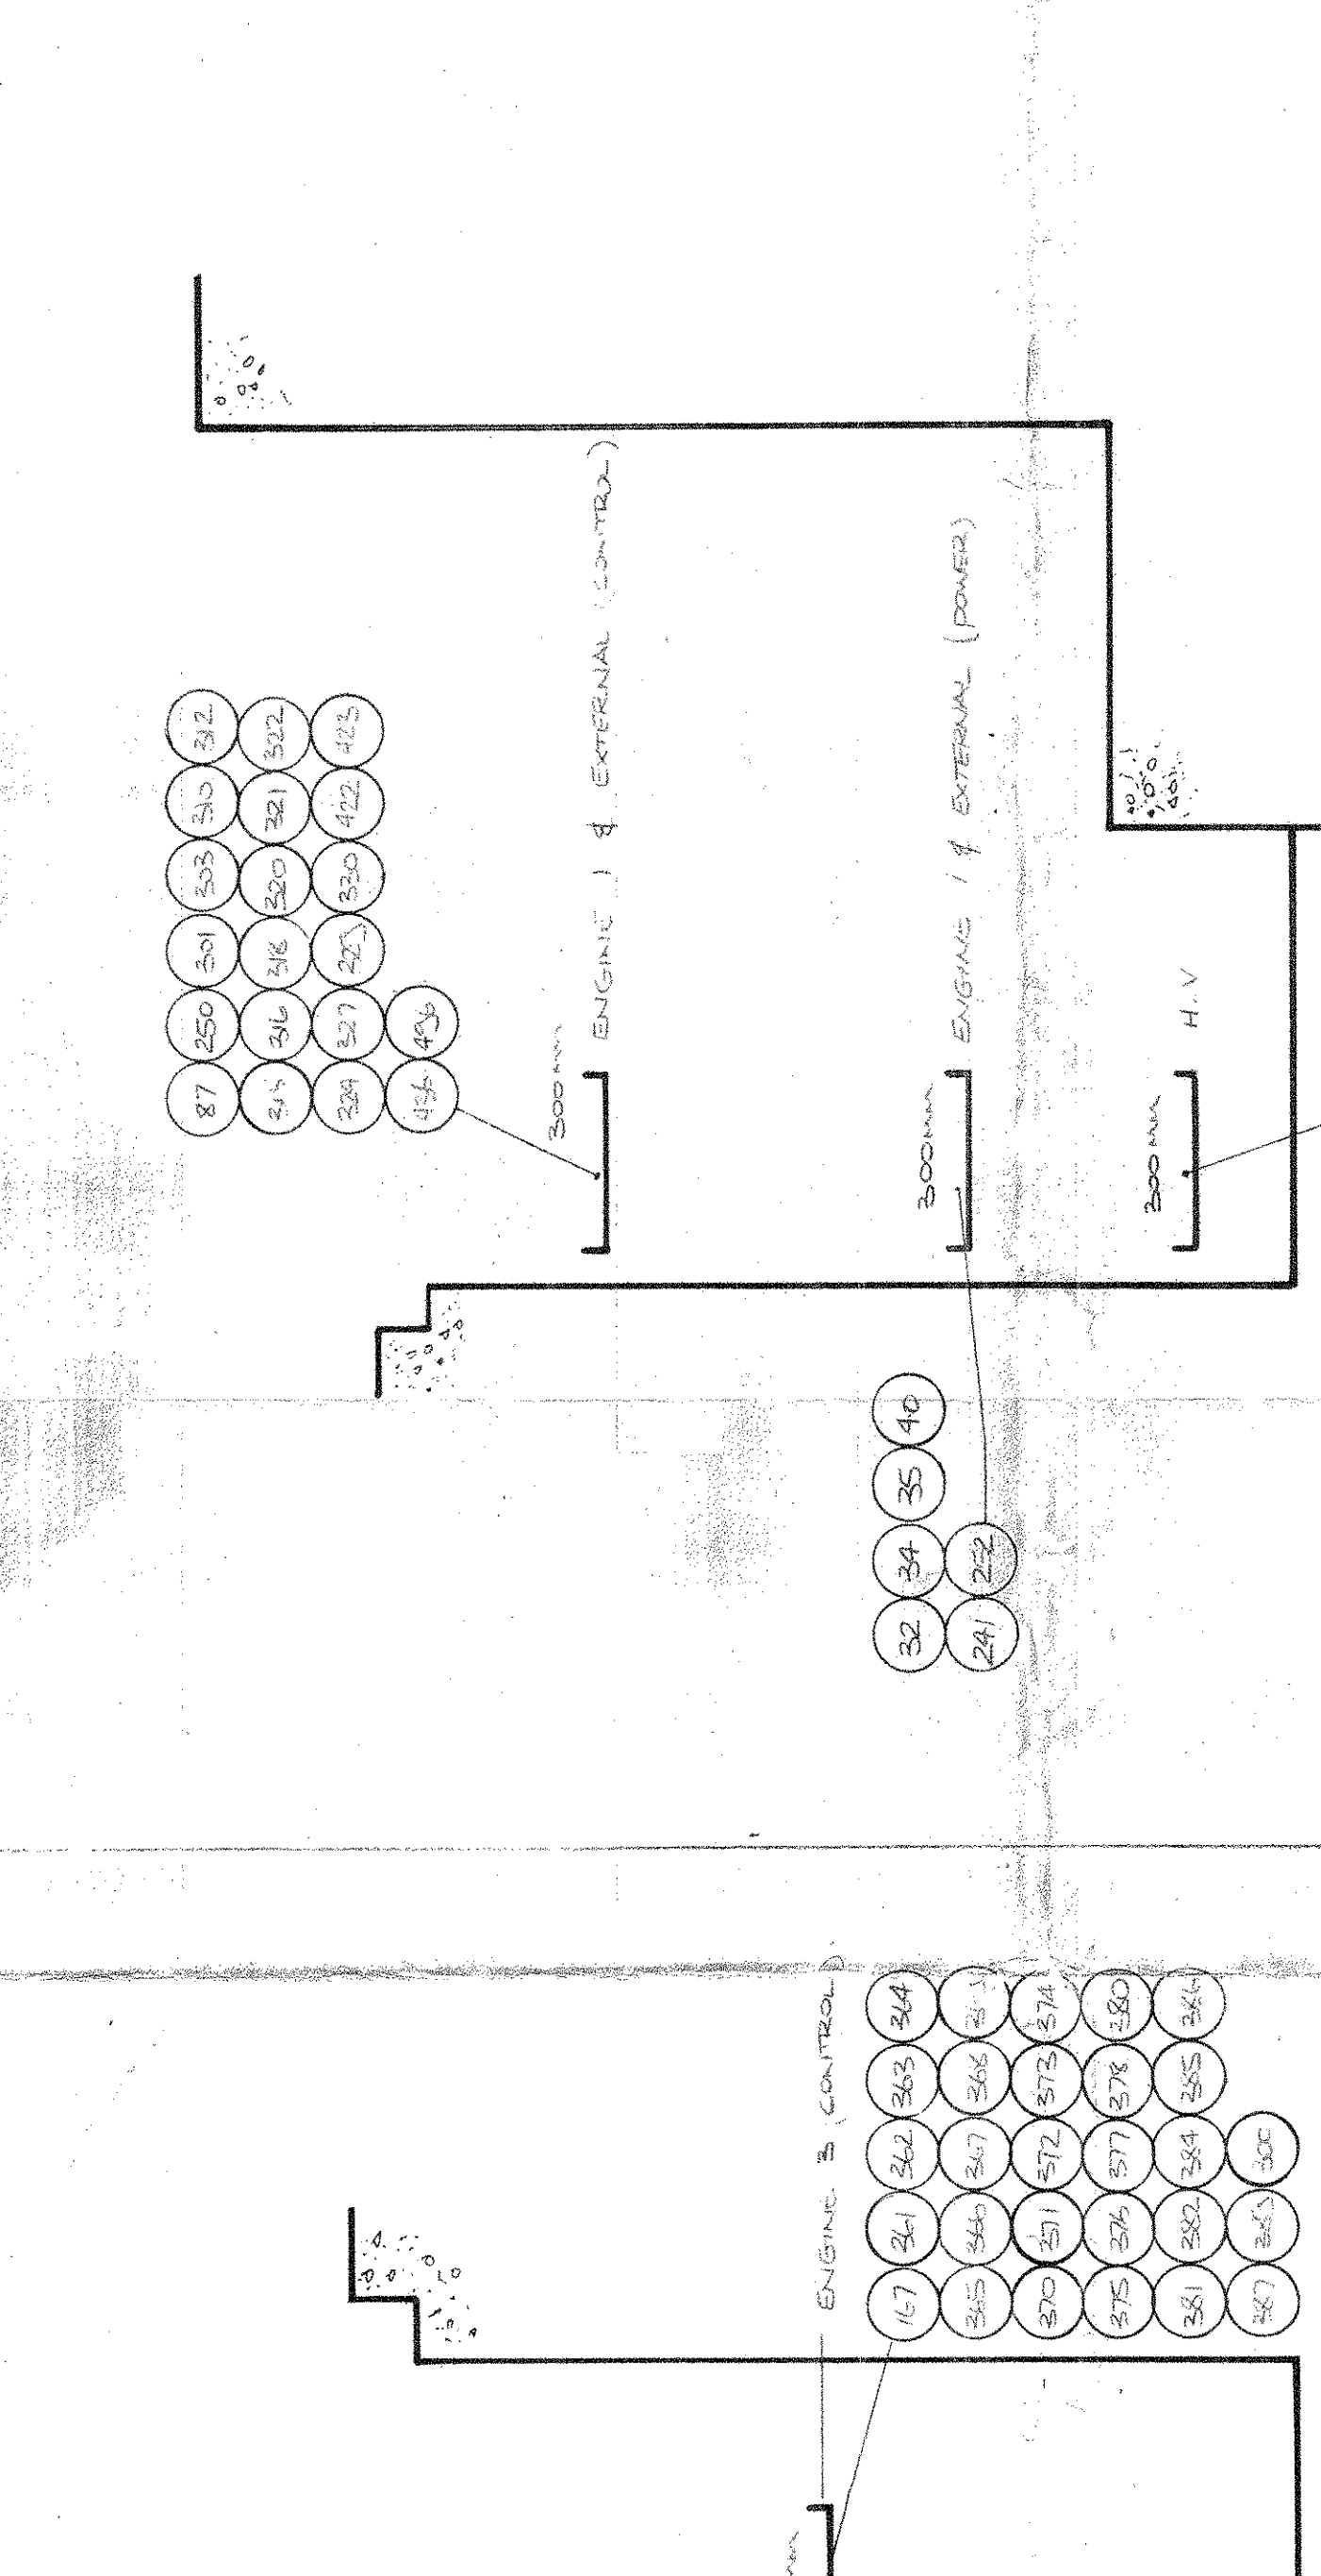


SECTION K-K


SECTION L-L

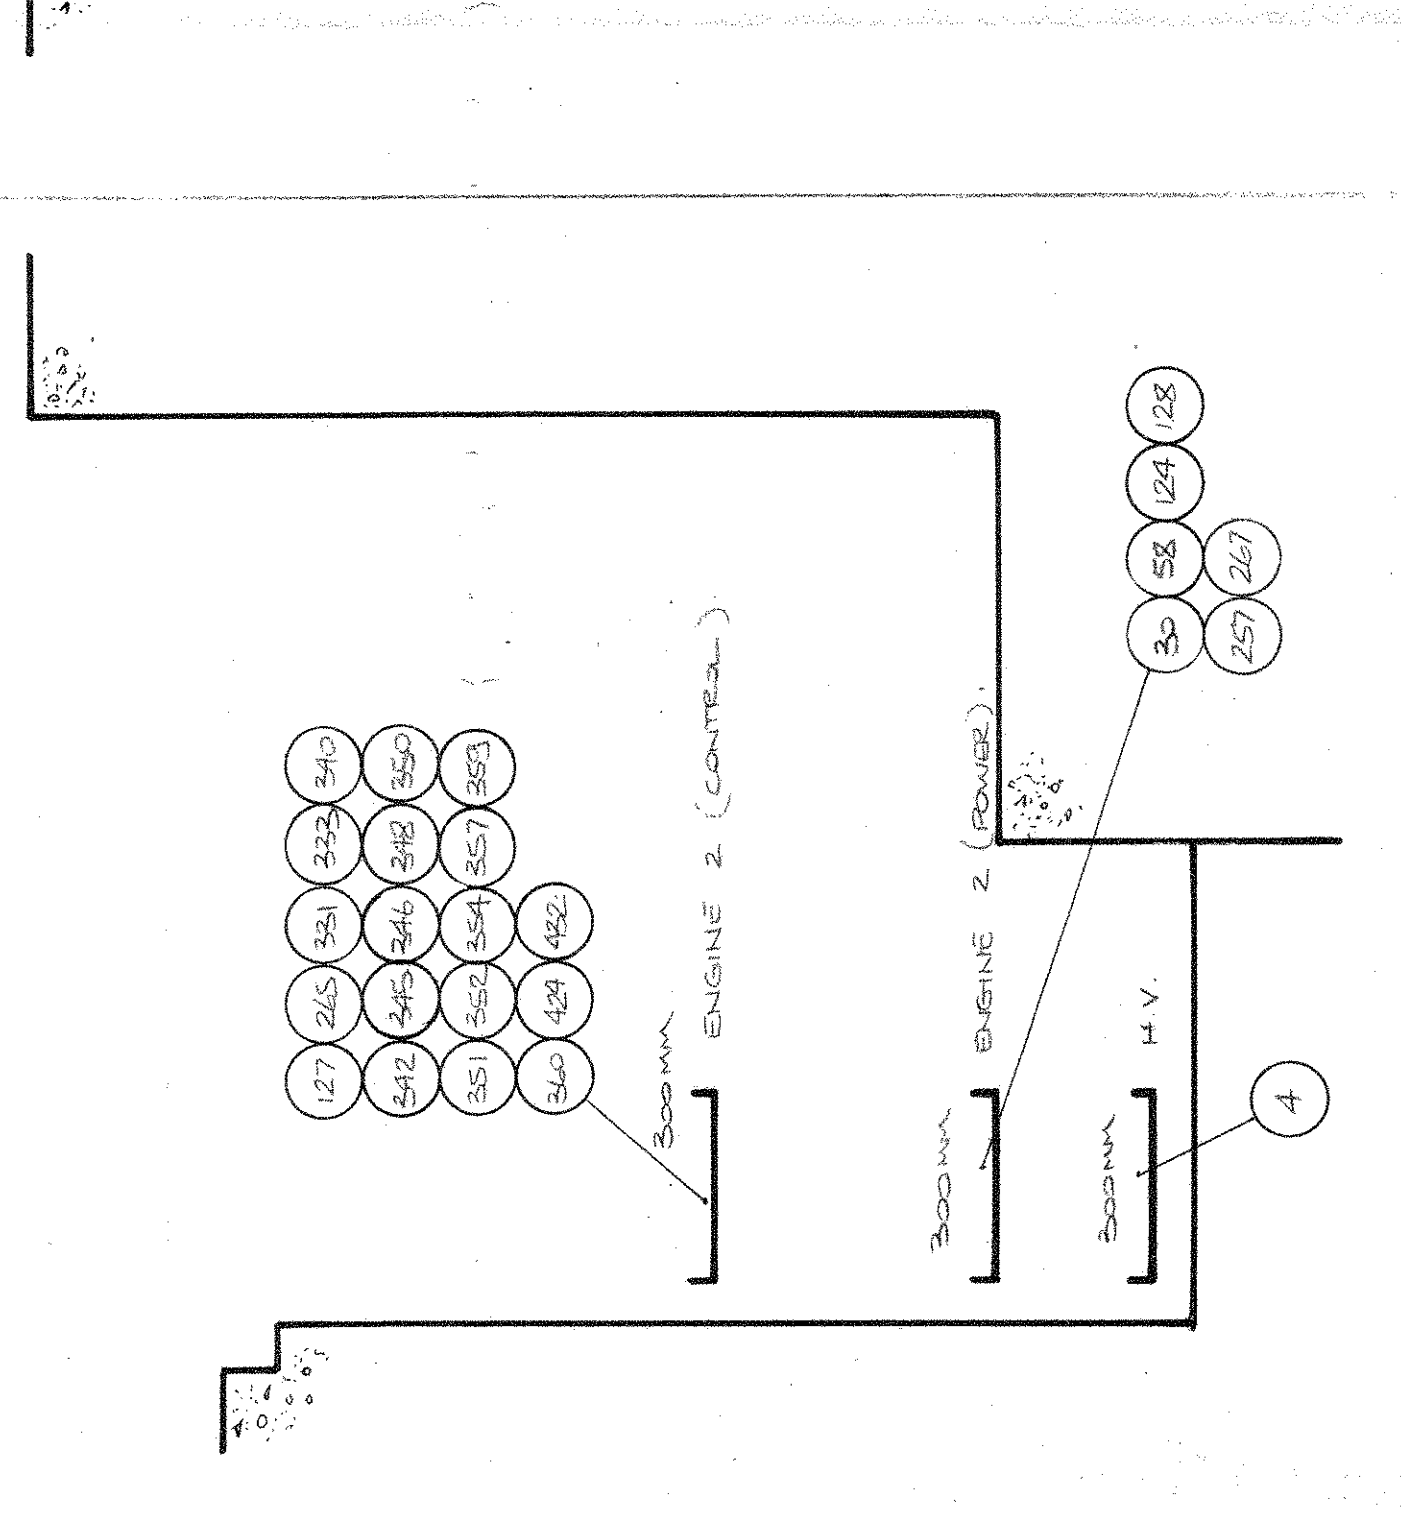


SECTION M-M

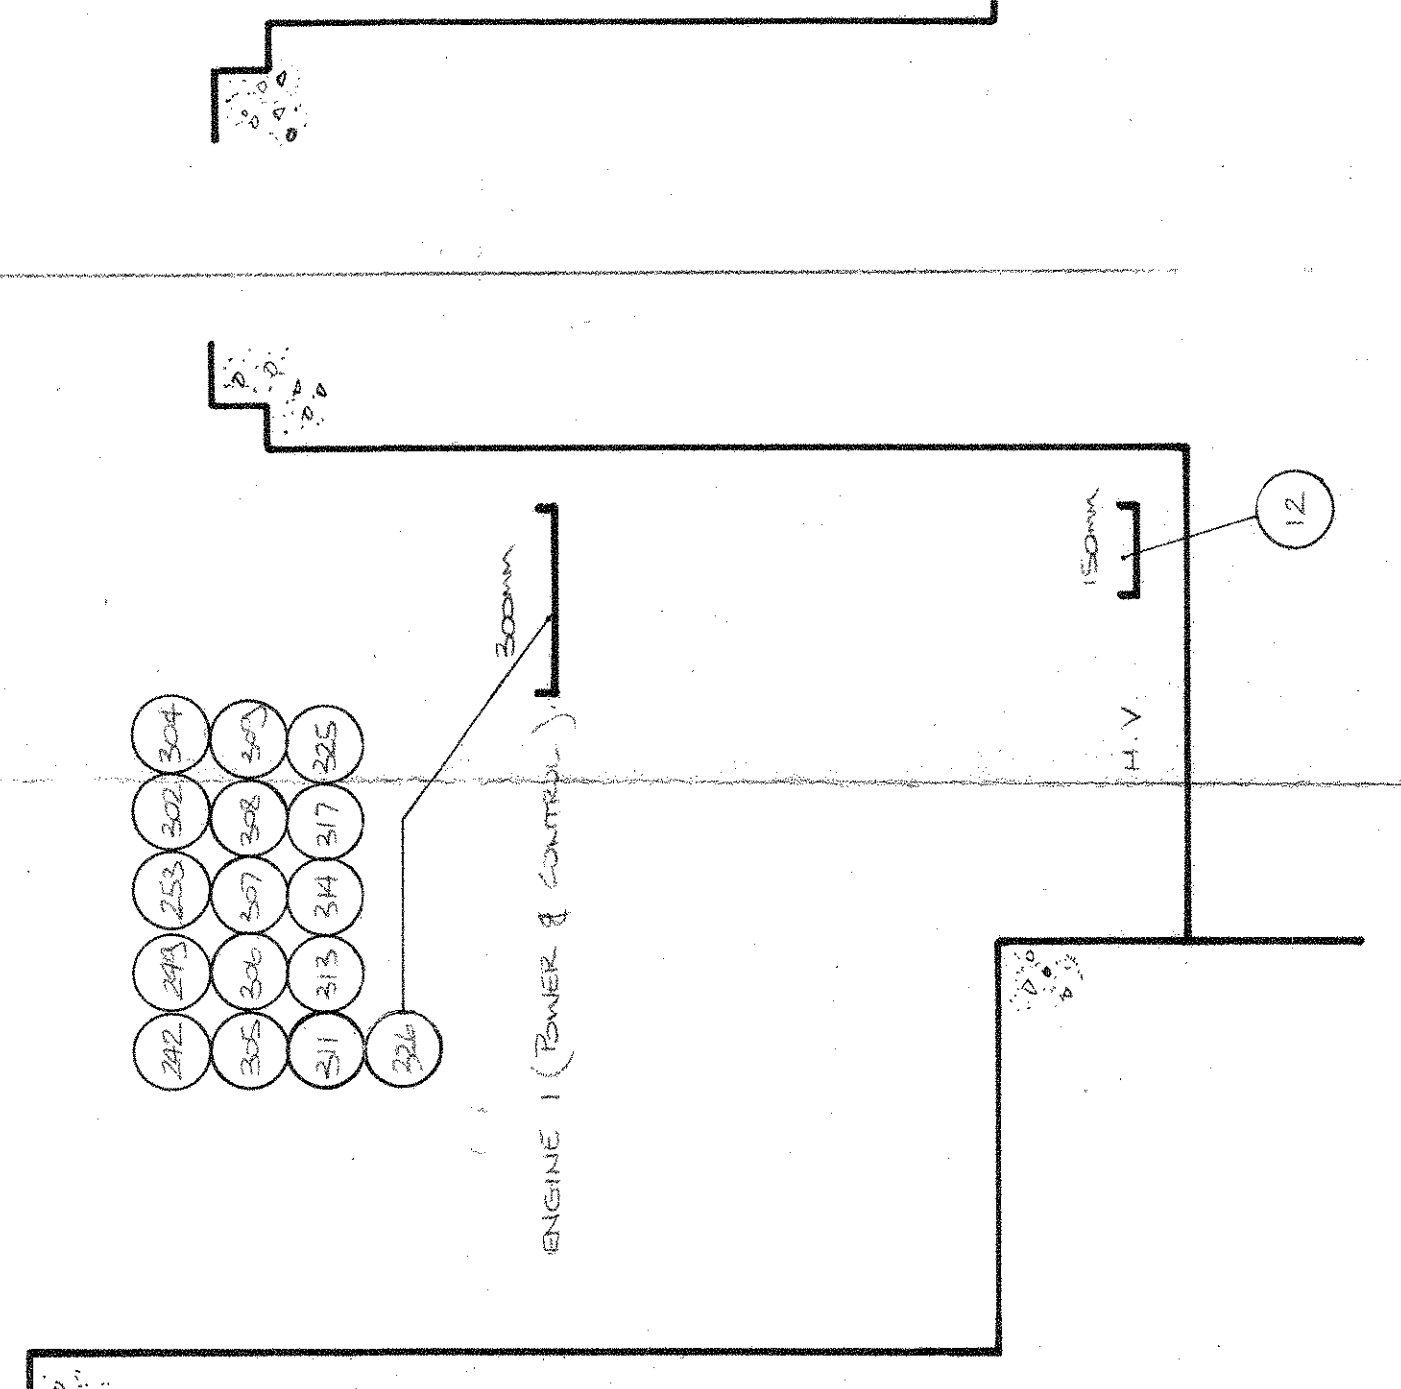


SECTION N-N

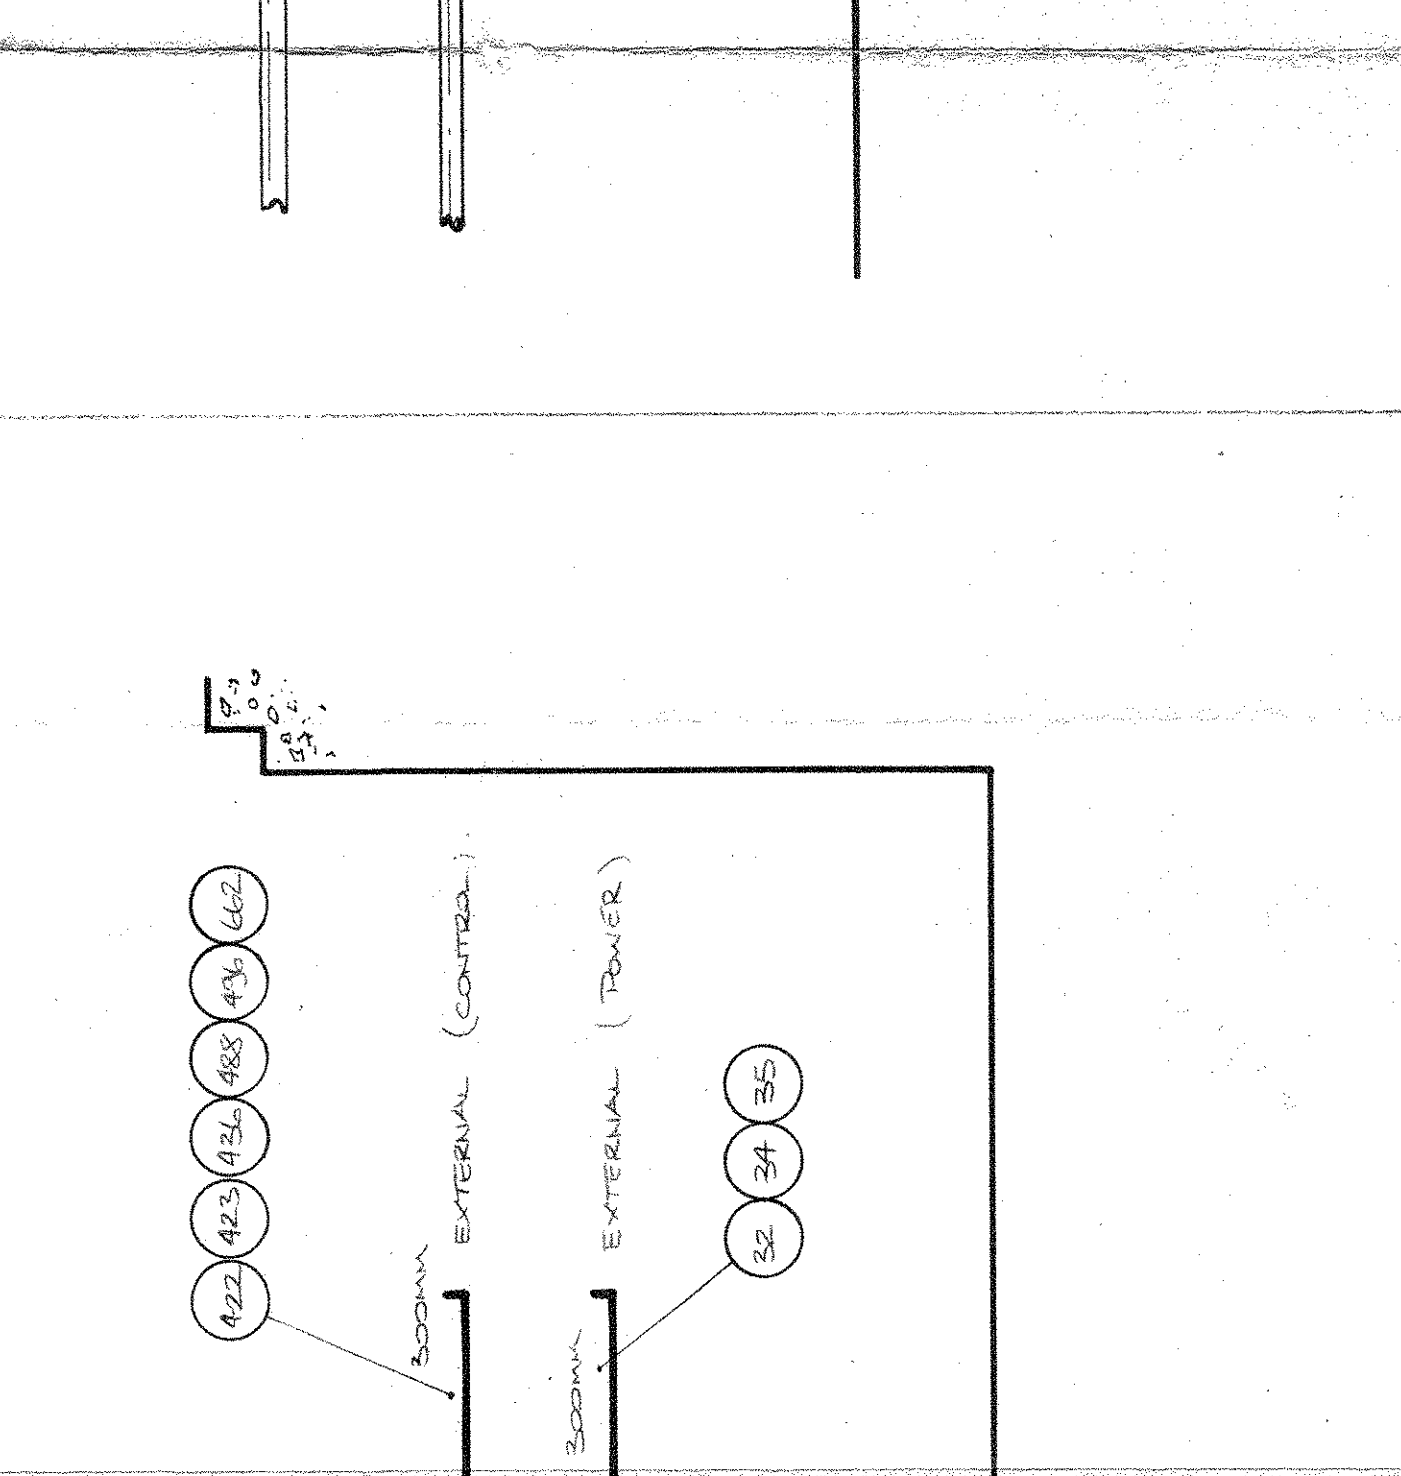

SECTION P-P

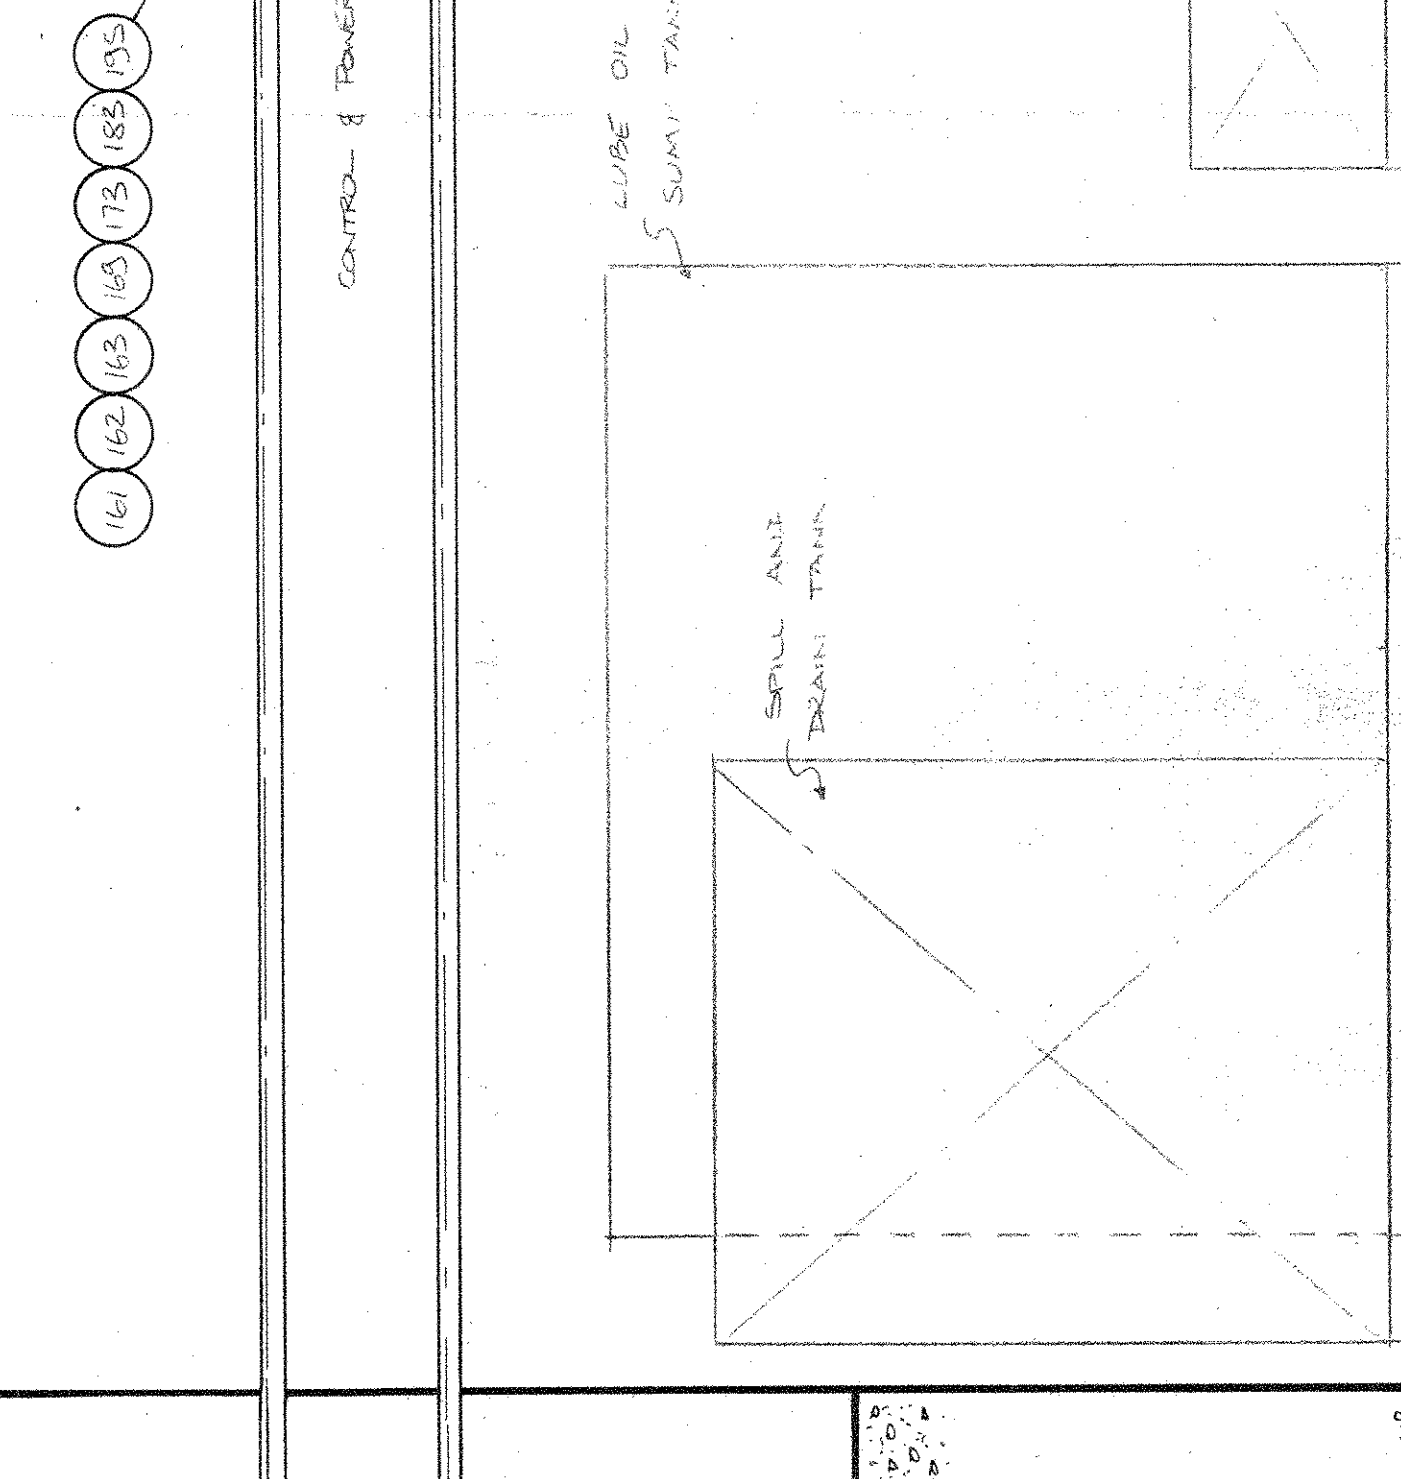

SECTION R-R

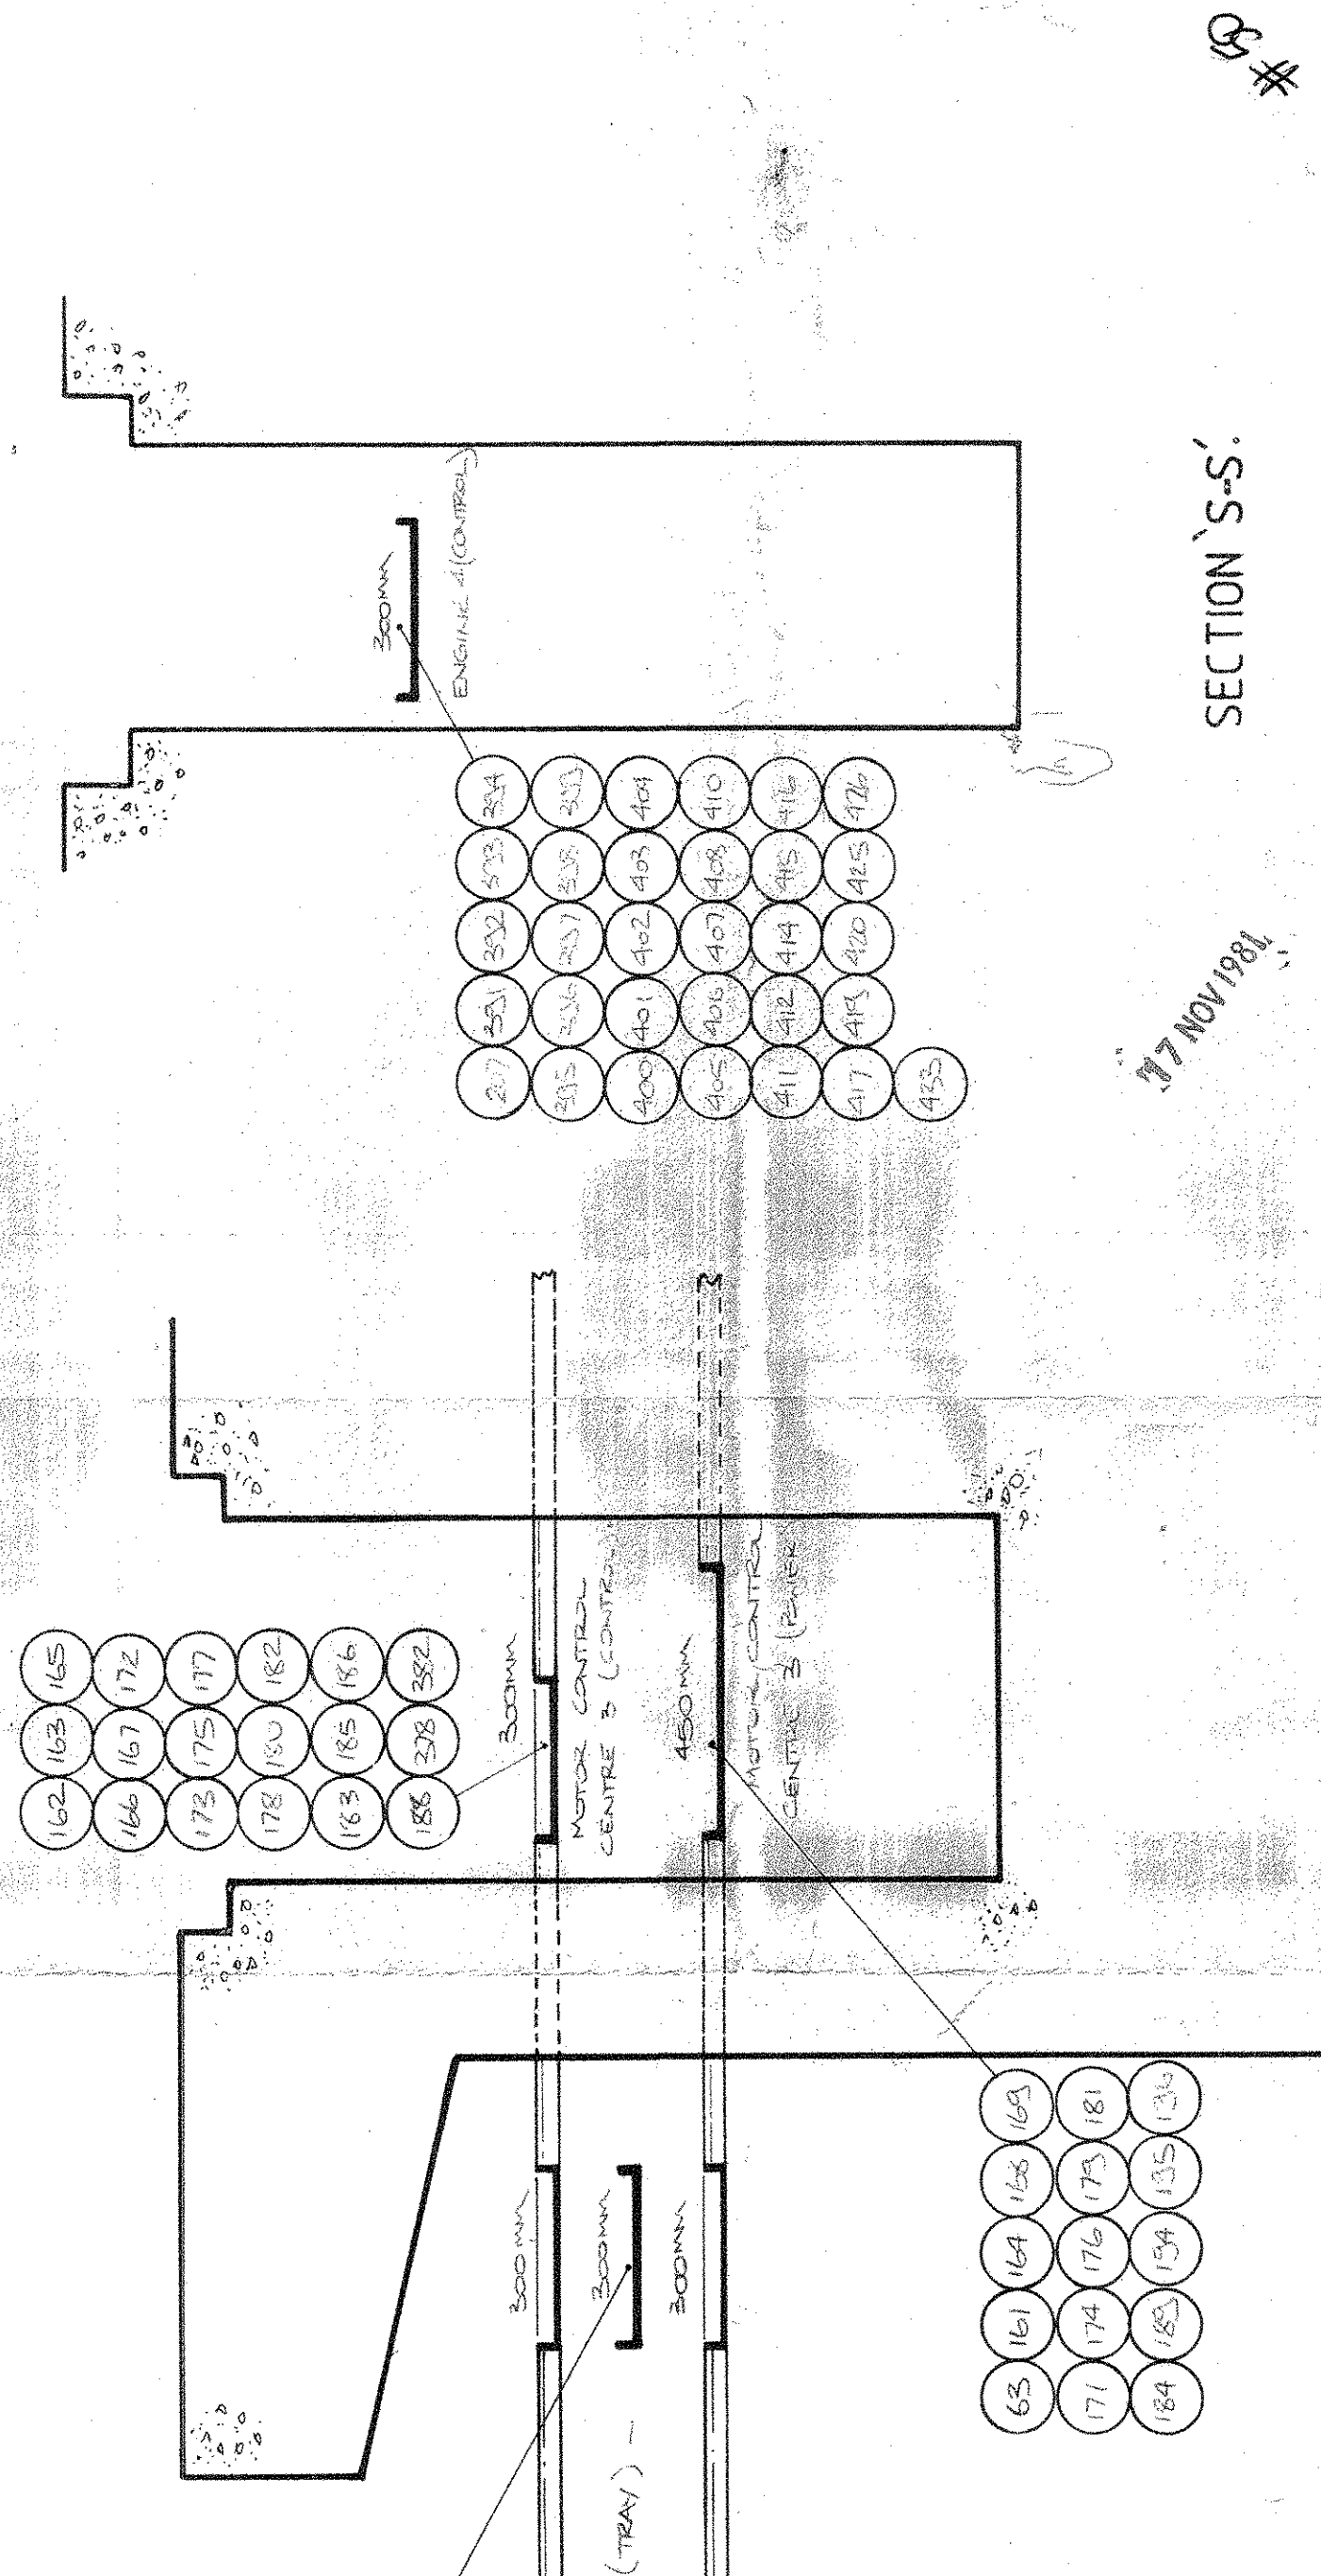

SECTION S-S

MAIN CONTRACTOR APE-CROSSLEY LTD.	PROJECT MAJURO POWER STATION
PRIME CONTRACTOR PSEC INTERNATIONAL POWER SYSTEMS LTD INTERNATIONAL TRADING LONDON SW14 6JL	CLIENT THE GOVERNMENT OF THE MARSHALL ISLANDS
SCALE 1:100	DRAWN RWS
CHECKED RWS	APPROVED RWS
TITLE ENGINE HALL GROUND FLOOR LEVEL SECTIONS THROUGH FLOOR TRAYS SHOWING CABLE TRAYS	W.H. SMITH & CO. ELECTRICAL ENGINEERS LTD.
REVISION	DRAWING NO. WHS/13634
DRAWN	DATE
CHECKED	DATE

17 NOV 1981