


ROOF LEVEL ABOVE FUEL TREATMENT ROOM

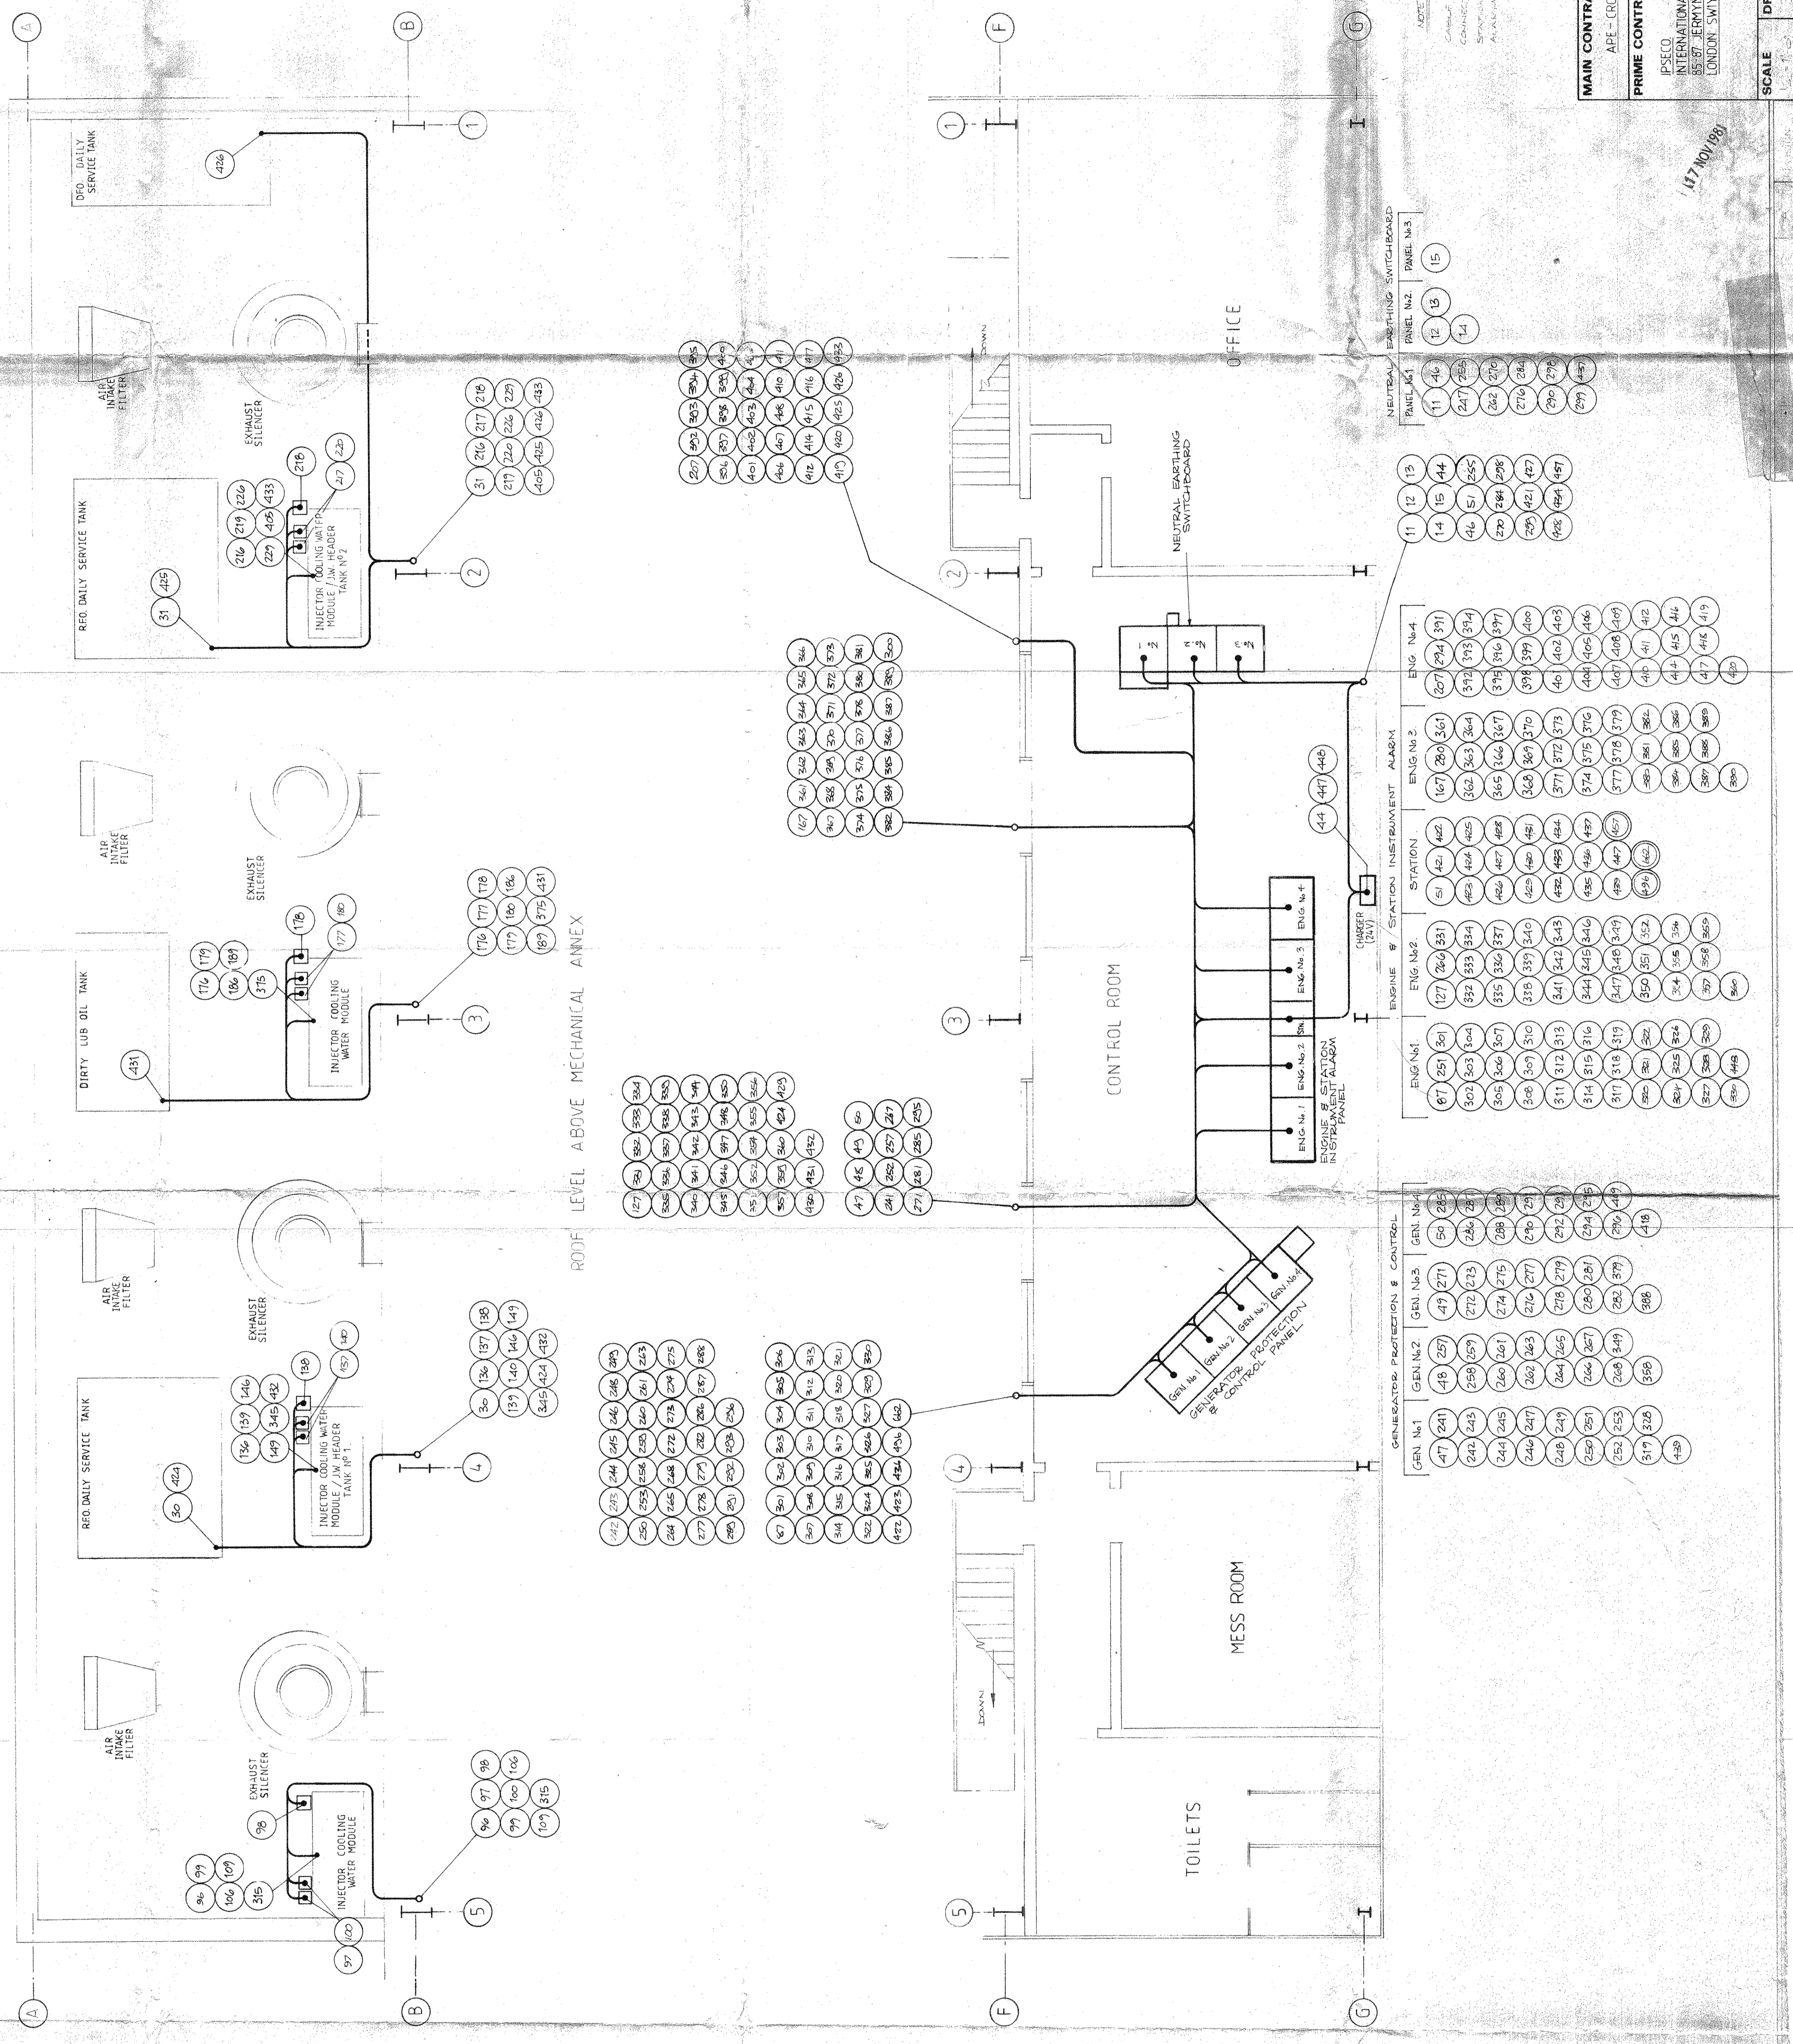

ROOF LEVEL ABOVE MECHANICAL ANNEX

<b>MAIN CONTRACTOR</b> APE - CROSSLEY LTD.	<b>PROJECT</b> MAJURO POWER STATION
<b>SCALE</b> AS SHOWN	<b>APPROVED</b>
<b>TITLE</b> ENGINE HALL FIRST FLOOR CABLE ROUTING	<b>W.H. SMITH &amp; CO.</b> ELECTRICAL ENGINEERS LTD.
<b>DRAWING NO.</b> WHS/10024	

1:87 (10/1/89)

APPROVED FOR THE CONTRACTOR BY THE ENGINEER IN CHARGE OF THE PROJECT  
W.H. SMITH & CO.  
ELECTRICAL ENGINEERS LTD.